


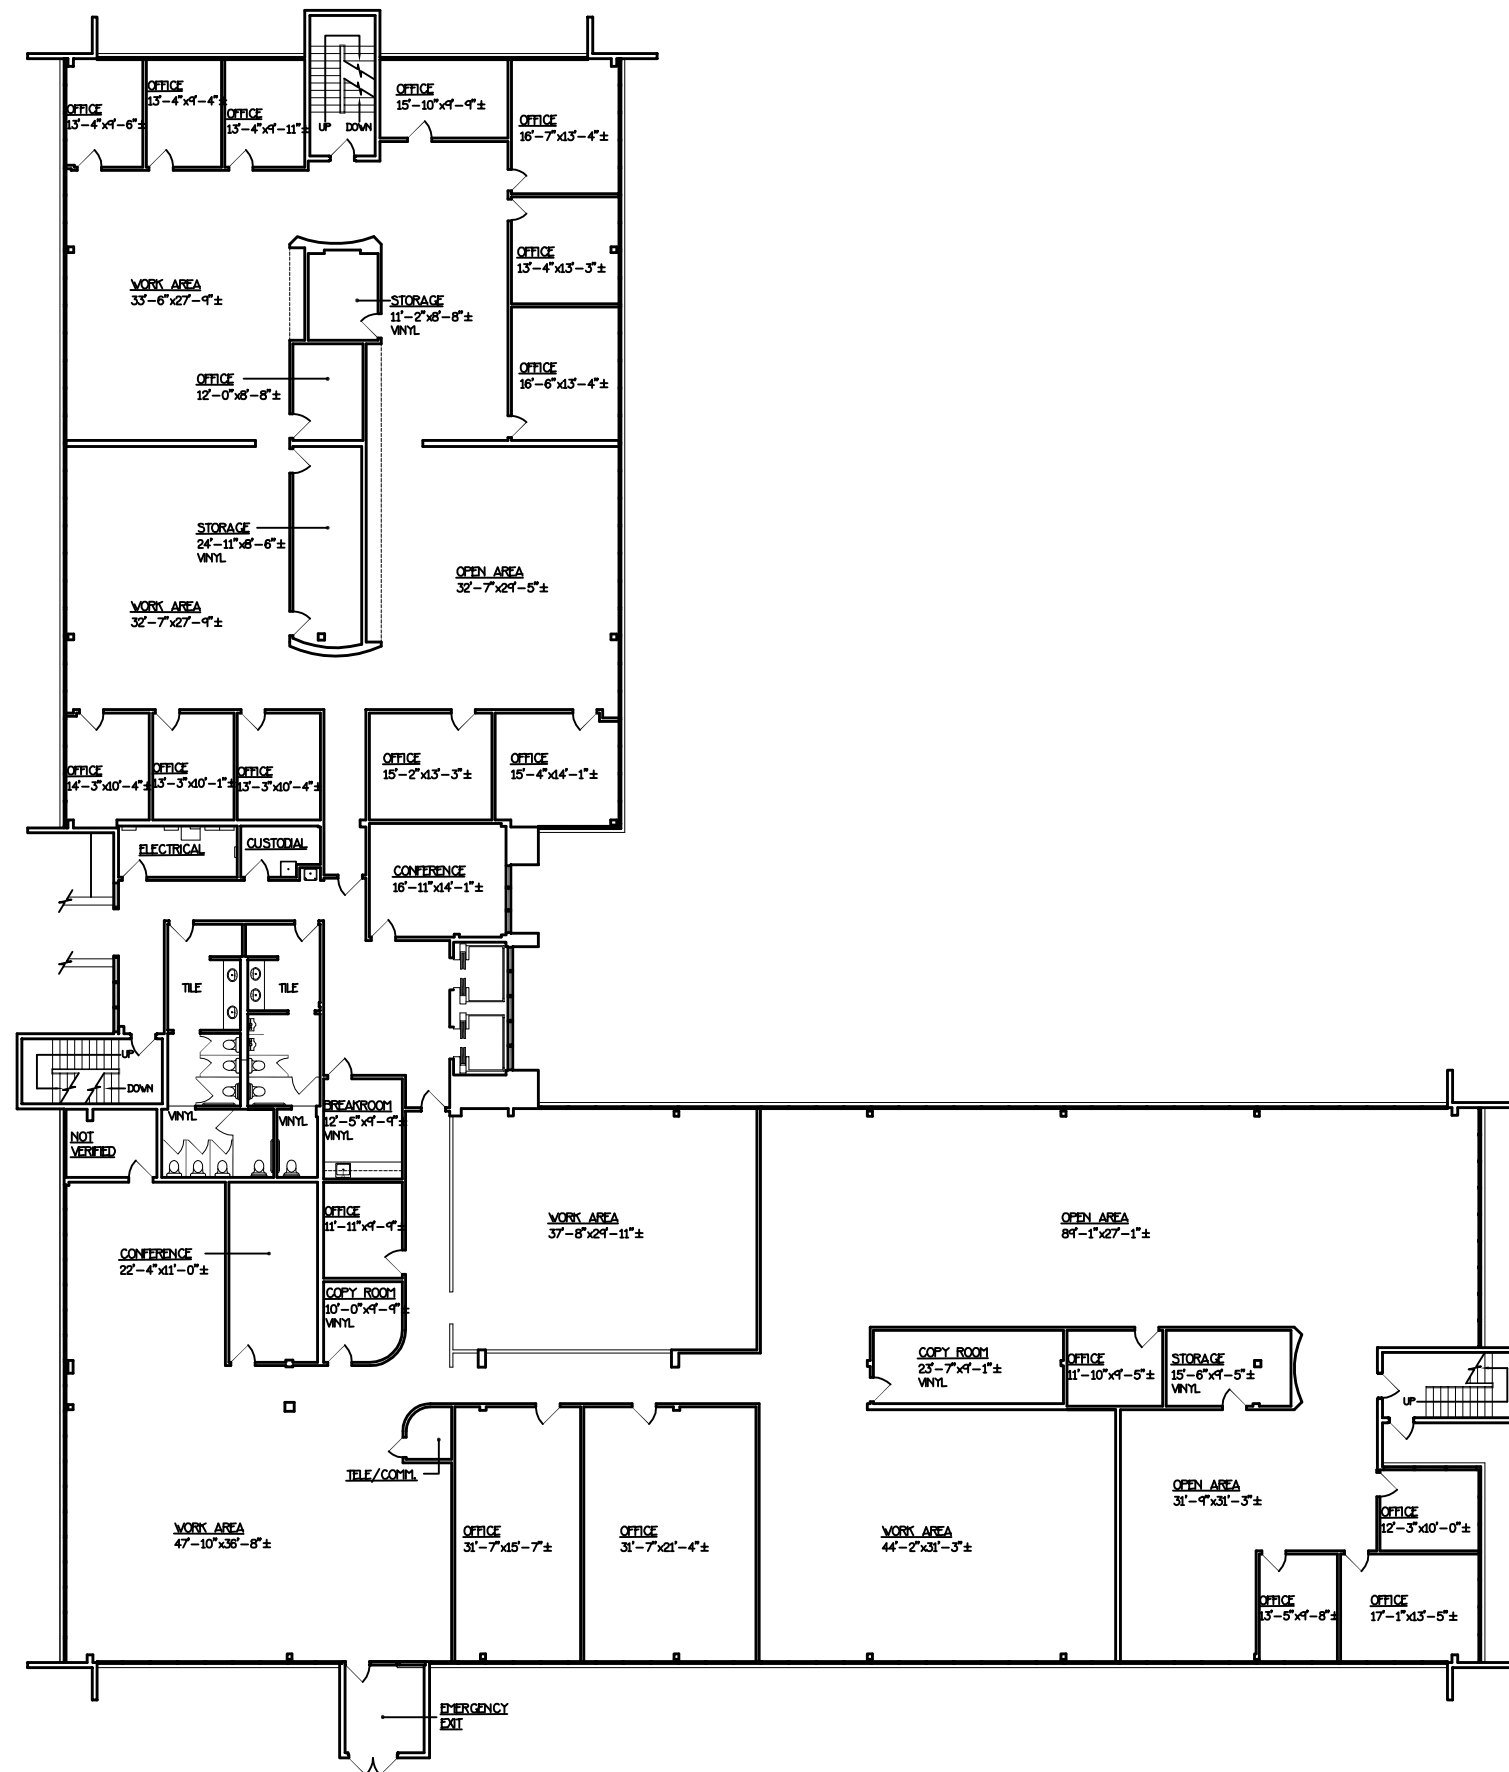


SECOND FLOOR

### NOTES

1. ALL CALCULATIONS INDICATE "USABLE" AREA AS PER "BOMA" STANDARDS.
2. ALL FIXTURES INDICATED ARE BUILT-IN.
3. ALL FLOORS ARE CARPET UNLESS OTHERWISE INDICATED.
4. ALL CEILING HEIGHTS ARE 8'-0" UNLESS OTHERWISE NOTED.
5. ALL DIMENSIONS TO BE FIELD VERIFIED PRIOR TO ANY CONSTRUCTION.
6. CALCULATIONS EXCLUDE ALL VERTICAL PENETRATIONS AND STAIR WELLS.

### AREA CALCULATIONS:

SECOND FLOOR AREA 19,826.79 SQ. FT.

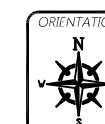

SCALE  
3/32"=1'-0"

DATE  
01/17/13

SHEET #  
**02**  
OF 04

|             |      |
|-------------|------|
| MEASURED BY | JR   |
| DESIGNED BY | N.A. |
| DRAFTED BY  | JR   |
| CHECKED BY  | P.M. |
| REVISED:    |      |

|          |   |
|----------|---|
| REVISION | 0 |
|          | 5 |
|          | 0 |
|          | 1 |
|          | 5 |



YCD DESIGNS  
505-899-1199

PROJECT:  
**2501  
BUENA VISTA  
DRIVE SE  
SECOND FLOOR**

DESCRIPTION:  
**AS-BUILT  
DRAWING**

CLIENT:  
**REIT  
MANAGEMENT**