

NOTES TO ARCHITECT:
1. ISLAND WALL LOCATION DETERMINED BY VISUAL MERCHANDISING.
2. CONFIRM LOCATION OF LUMI-SIGN W/ STORE DESIGN.
3. FLOOR PLAN IS HYPOTHETICAL AND FOR ILLUSTRATIVE PURPOSES ONLY. REFER TO DESIGN SKETCHES FOR ACTUAL LAYOUT.

4. MAINTAIN PROTOTYPICAL FITTING ROOM CONFIGURATION AND DOOR SWINGS FOR MANUFACTURING CONSISTENCY.
5. FOR LOCATIONS REQUIRING VESTIBULE, SEE MODEL SPACE FOR VESTIBULE OPTION.


FLOOR PLAN


SCALE:
1/8" = 1'-0"

2

FLOOR PLAN KEY NOTES

1

| KEY | DESCRIPTION | DET./SHT. | NEW STORE |
|---|---|--------------------|--|
| (1) | 24" SHELVING ON STANDARDS AT BACK OF HOUSE (WHERE OCCURS) | 2/A6-4 | <div></div> <div>GAP INC. CORPORATE ARCHITECTURE 1 HARRISON STREET SAN FRANCISCO, CA. 94105</div> <div>STORE NO.: XXXX</div> <div>STORE NAME: XXXX</div> <div>STORE LOCATION: XXXXX</div> <div>GAP PROJ. I.D.: 00000XXXX</div> <div>PROTOTYPE DATE: 07/01/11 OPENING 2012</div> <div>CONSULTANT INFO:</div> <div>PROFESSIONAL STAMP:</div> <div>ARCHITECT INFO:</div> <div>ISSUE TYPE:</div> <div>SCALE: AS NOTED</div> <div>DRAWN BY: XX/XX</div> <div>A&E JOB NO.: XXXX</div> <div>SHEET TITLE:</div> <div>FLOOR PLAN</div> <div>8,000 S.F. - VERSION</div> <div>SHEET NUMBER: A2-0</div> |
| (2) | (2) 14" SHELVES ON STANDARDS AT MOP SINK | 1/A6-4 | |
| (3) | 14" SHELVING ON STANDARDS AT MANAGER'S OFFICE | 1/A6-4 | |
| (4) | UNISTRUT HANGROD @ 11'-0" A.F.F. | 12/A6-4b | |
| (5) | NOT USED | | |
| (6) | NOT USED | | |
| (7) | RECESSED STANDARDS @ PERIMETER WALLS & T-WALLS FROM 6" A.F.F. TO 8'-6" A.F.F., AT ISLAND WALLS FROM 6" A.F.F. TO 7'-6" A.F.F. | 12/A6-6 | |
| (8) | CHAIR RAIL AT ALL HIGH TRAFFIC AREAS FROM BOH TO SALES, MOUNT BOTTOM AT 2'-6" A.F.F., PAINT TO MATCH WALL. | 9/A6-1 | |
| (9) | LOCKERS - INSTALL PER MANUFACTURER EACH TYP. IS 18" X 6-0" X 72"H. WHERE OCCURS: INSTALL 24" SHELVING ABOVE FROM 6'-6" TO 2'-0" BELOW B.O. SPRINKLER HEAD ON SURFACE MOUNTED STANDARDS. | 3/A6-4 SIM. | |
| (10) | NOT USED | | |
| (11) | NETWORK RACK: 24" W X 32" H X 30" D: MOUNT TO TELEPHONE BACK BOARD WITH BOTTOM OF RACK AT 84" A.F.F. MINIMUM. | 6/A6-4 SEE ELEC. | |
| (12) | REFRIGERATOR AND MICROWAVE (N.I.C.), PROVIDE DUPLEX OUTLET WITH SEPARATE DEDICATED CIRCUIT FOR EACH APPLIANCE | SEE ELEC. | |
| (13) | EMPLOYEE TIME CLOCK (24" SHELVING ABOVE ON SURFACE MOUNTED STANDARDS, WHERE OCCURS) | 3/4/A6-4 SEE ELEC. | |
| (14) | BULLETIN BOARD - OWNER FURNISHED, T.O. BOARD @ 6'-0" A.F.F. (24" SHELVING ABOVE ON SURFACE MOUNTED STANDARDS, WHERE OCCURS) | 3/A6-4 | |
| (15) | DRINKING FOUNTAIN, INSTALL PER MANUFACTURER'S SPECIFICATIONS AND LOCAL CODE - USE WATER RESISTANT GYP. BD. | 7/A6-5 SEE PLUMB. | |
| (16) | ELECTRICAL PANELS, INSTALL STRIPING ON THE FLOOR INDICATING MIN. 3'-0" CLEAR SPACE IN FRONT OF PANELS. PAINT (P107) PRIOR TO SEALING WITH (S100) | 6/A6-4 SEE ELEC. | |
| (17) | OLDCASTLE STOREFRONT SYSTEM | | |
| (18) | 8'-1" X 8'-1" LUMI SIGN | 5/A4-2b | |
| (19) | (E) STOREFRONT SYSTEM BY (LANDLO) UNLESS OTHERWISE NOTED. | | |
| (20) | NOT USED | | |
| (21) | PRE-FABRICATED FITTING ROOMS | 1/A6-2 | |
| (22) | CASHWRAP | A7-0 | |
| (23) | MOP SINK, PROVIDE HOSE ON SPIGOT CUT TO 3'-0" LENGTH, WATER RESISTANT GYP. BD. TYP. AT ALL WALLS. | SEE PLUMB. | |
| (24) | (E) STRUCTURAL COLUMN PAINT (P10) BELOW (9'-6" A.F.F. (P104) ABOVE (9'-6" A.F.F. | 1/A0-4 | |
| (25) | NOT USED | | |
| (26) | RDS COMPOSITE PANEL SYSTEM, TYP. - WHERE (N) STOREFRONT SYSTEM OCCURS | 1/A5-0 | |
| (27) | GYP. BOARD LID AT VOID | 1/A6-7 | |
| (28) | PLATFORM DIVIDERS ABOVE MANAGER'S OFFICE | 3/A6-4b | |
| (29) | WALL MOUNTED HANGER TIGHTS @ CASHWRAP, PROVIDE BLOCKING | 1/A4-2b | |
| (30) | VENDING MACHINES (N.I.C.), PROVIDE SEPARATE DEDICATED CIRCUIT FOR EACH. | SEE ELEC. | |
| (31) | 10'-0"H HIGH DENSITY FIXED SHELVING WITH (2) ROWS OF 24" SHELVING ABOVE ON SURFACE MOUNTED STANDARDS (WHERE OCCURS) | 7/A6-4 | |
| (32) | 10'-0"H HIGH DENSITY FIXED SHELVING WITH (1) ROW OF 24" SHELVING ABOVE ON SURFACE MOUNTED STANDARDS AT WALL BEHIND FITTING ROOMS (WHERE OCCURS) | 7/A6-4 SIM. | |
| (33) | T-WALLS & ISLAND WALLS: 5/8" GYP. BOARD ON METAL STUDS WITH RECESSED STANDARDS AT 24" O.C. | A6-6 | |
| (34) | STAINLESS STEEL CORNER GUARDS - 48"H A.F.F. TYP. | 2/A6-1 | |
| (35) | CHAIR RAIL (DOES NOT OCCUR AT PLATFORM) | 9A/A4-2a | |
| (36) | METAL CANOPY (OCCURS AT EXTERIOR LOCATIONS ONLY AS SPECIFIED BY STORE DESIGN) | | |
| (37) | DOOR BUZZER | SEE ELEC. | |
| (38) | MIN. 5'X5' LEVEL LANDING, MAX. 2% SLOPE REQUIRED AT EXIT DOORS. | | |
| (39) | DISPLAY AREA RAISED PLATFORM (WHERE OCCURS) | 5/A4-2b | |
| (40) | RECESSED STANDARDS AT 24" O.C. TYP. AT END PANEL | A6-6 | |
| (41) | COMPLETE SET OF AS-BUILT DRAWINGS IN PLASTIC TUBE SECURED TO WALL. SEND SECOND SET TO GAP PROJECT MANAGER. | SEE PLUMB. | |
| (42) | NOT USED | | |
| (43) | 48"L X 12"H HANGROD @ EMPLOYEE LOUNGE FOR COATS - MOUNT AT 4'-0" A.F.F. BLOCK AS REQUIRED (SHELVING ABOVE ON SURFACE MOUNTED STANDARDS) | 3/A6-4 SIM. | |
| (44) | 48"H DISPLAY WALL BEHIND CASHWRAP | 12/A4-2b | |
| (45) | 8'-0"H HIGH DENSITY FIXED SHELVING AT 9'-6" WALLS | 7/A6-4 SIM. | |
| (46) | ACCESSIBLE LOCKER W/KEY PAD LOCK @ 40" A.F.F. MAX. | | |
| (47) | WALL DOOR OPENING W/ SALVAGED WINDOW SYS. FROM IN DOOR LOCATION (WHERE OCCURS) | | |
| (48) | FLOORING TRANSITION - VINYL TO CONCRETE | 8/A6-1 | |
| (49) | SAW-CUT/ CORE DRILL AND PATCH FLOOR SLAB AS REQUIRED FOR SANITARY FLOORING TRANSITION | 1/A6-5 SEE PLUMB. | |
| (50) | (2) 1/4" X 7/8" MITERED WOOD TRIM (P101) AT GYP. BOARD CORNERS THROUGHOUT UNLESS S.S. CORNER GUARDS ARE SPECIFIED | 11/A6-6 | |
| (51) | NOT USED | | |
| (52) | STAINLESS STEEL CORNER GUARDS - 96" A.F.F. TYP. | 2/A6-1 | |
| (53) | EAS SYSTEM FLOOR MOUNTED PEDESTALS | 1/A4-5 SEE ELEC. | |
| (54) | (E) 2'-0" X 4'-9" FITTING ROOM AREA MIRROR PROVIDED BY VENDOR - MOUNT BOTTOM AT 18" A.F.F. PROVIDE BLOCKING AS REQUIRED. | 11/A6-0 | |
| (55) | 1 X 6 WOOD TRIM AT SALES AREA (PERIMETER WALLS, T-WALLS), DISPLAY AREA, AND FITTING ROOMS. PAINT (P10) T.O. TRIM @ 9'-6" A.F.F. | A6-6 | |
| (56) | PHONE AND VOLUME CONTROL FOR FITTING ROOMS | SEE ELEC. | |
| (57) | SAW-CUT/ CORE DRILL AND PATCH FLOOR SLAB AS REQUIRED FOR CONDUIT. | A7-0 SEE ELEC. | |
| (58) | 6'-0"LX5'-7"W ENTRANCE WALK-OFF MAT, INSTALL SO THAT RAIL IS PERPENDICULAR TO TRAFFIC, USE AT EXTERIOR LOCATIONS ONLY | 4/A6-1 | |
| (59) | VOLUME CONTROL FOR SALES | SEE ELEC. | |
| (60) | VOLUME CONTROL FOR BACK OF HOUSE | SEE ELEC. | |
| 1. ALL DIMENSIONS TO FACE OF FINISH OR CENTERLINE OF COLUMN U.O.N. 2. REFER TO SHEET A2-1 FOR ENLARGED FLOOR PLANS 3. REFER TO SHEET A0-1 FOR RESPONSIBILITY MATRIX 4. REFER TO SHEET A0-4 FOR FINISH SCHEDULE 5. REFER TO SHEET A0-2 FOR DOOR SCHEDULE 6. REFER TO SHEET A2-1 FOR WALL TYPES 7. RELOCATE EXISTING AND FURNISH AND INSTALL NEW FIRE EXTINGUISHERS PER LOCAL CODE REQUIREMENTS. VERIFY LOCATION AND QUANTITIES WITH LIFE SAFETY INSPECTOR. | | | |

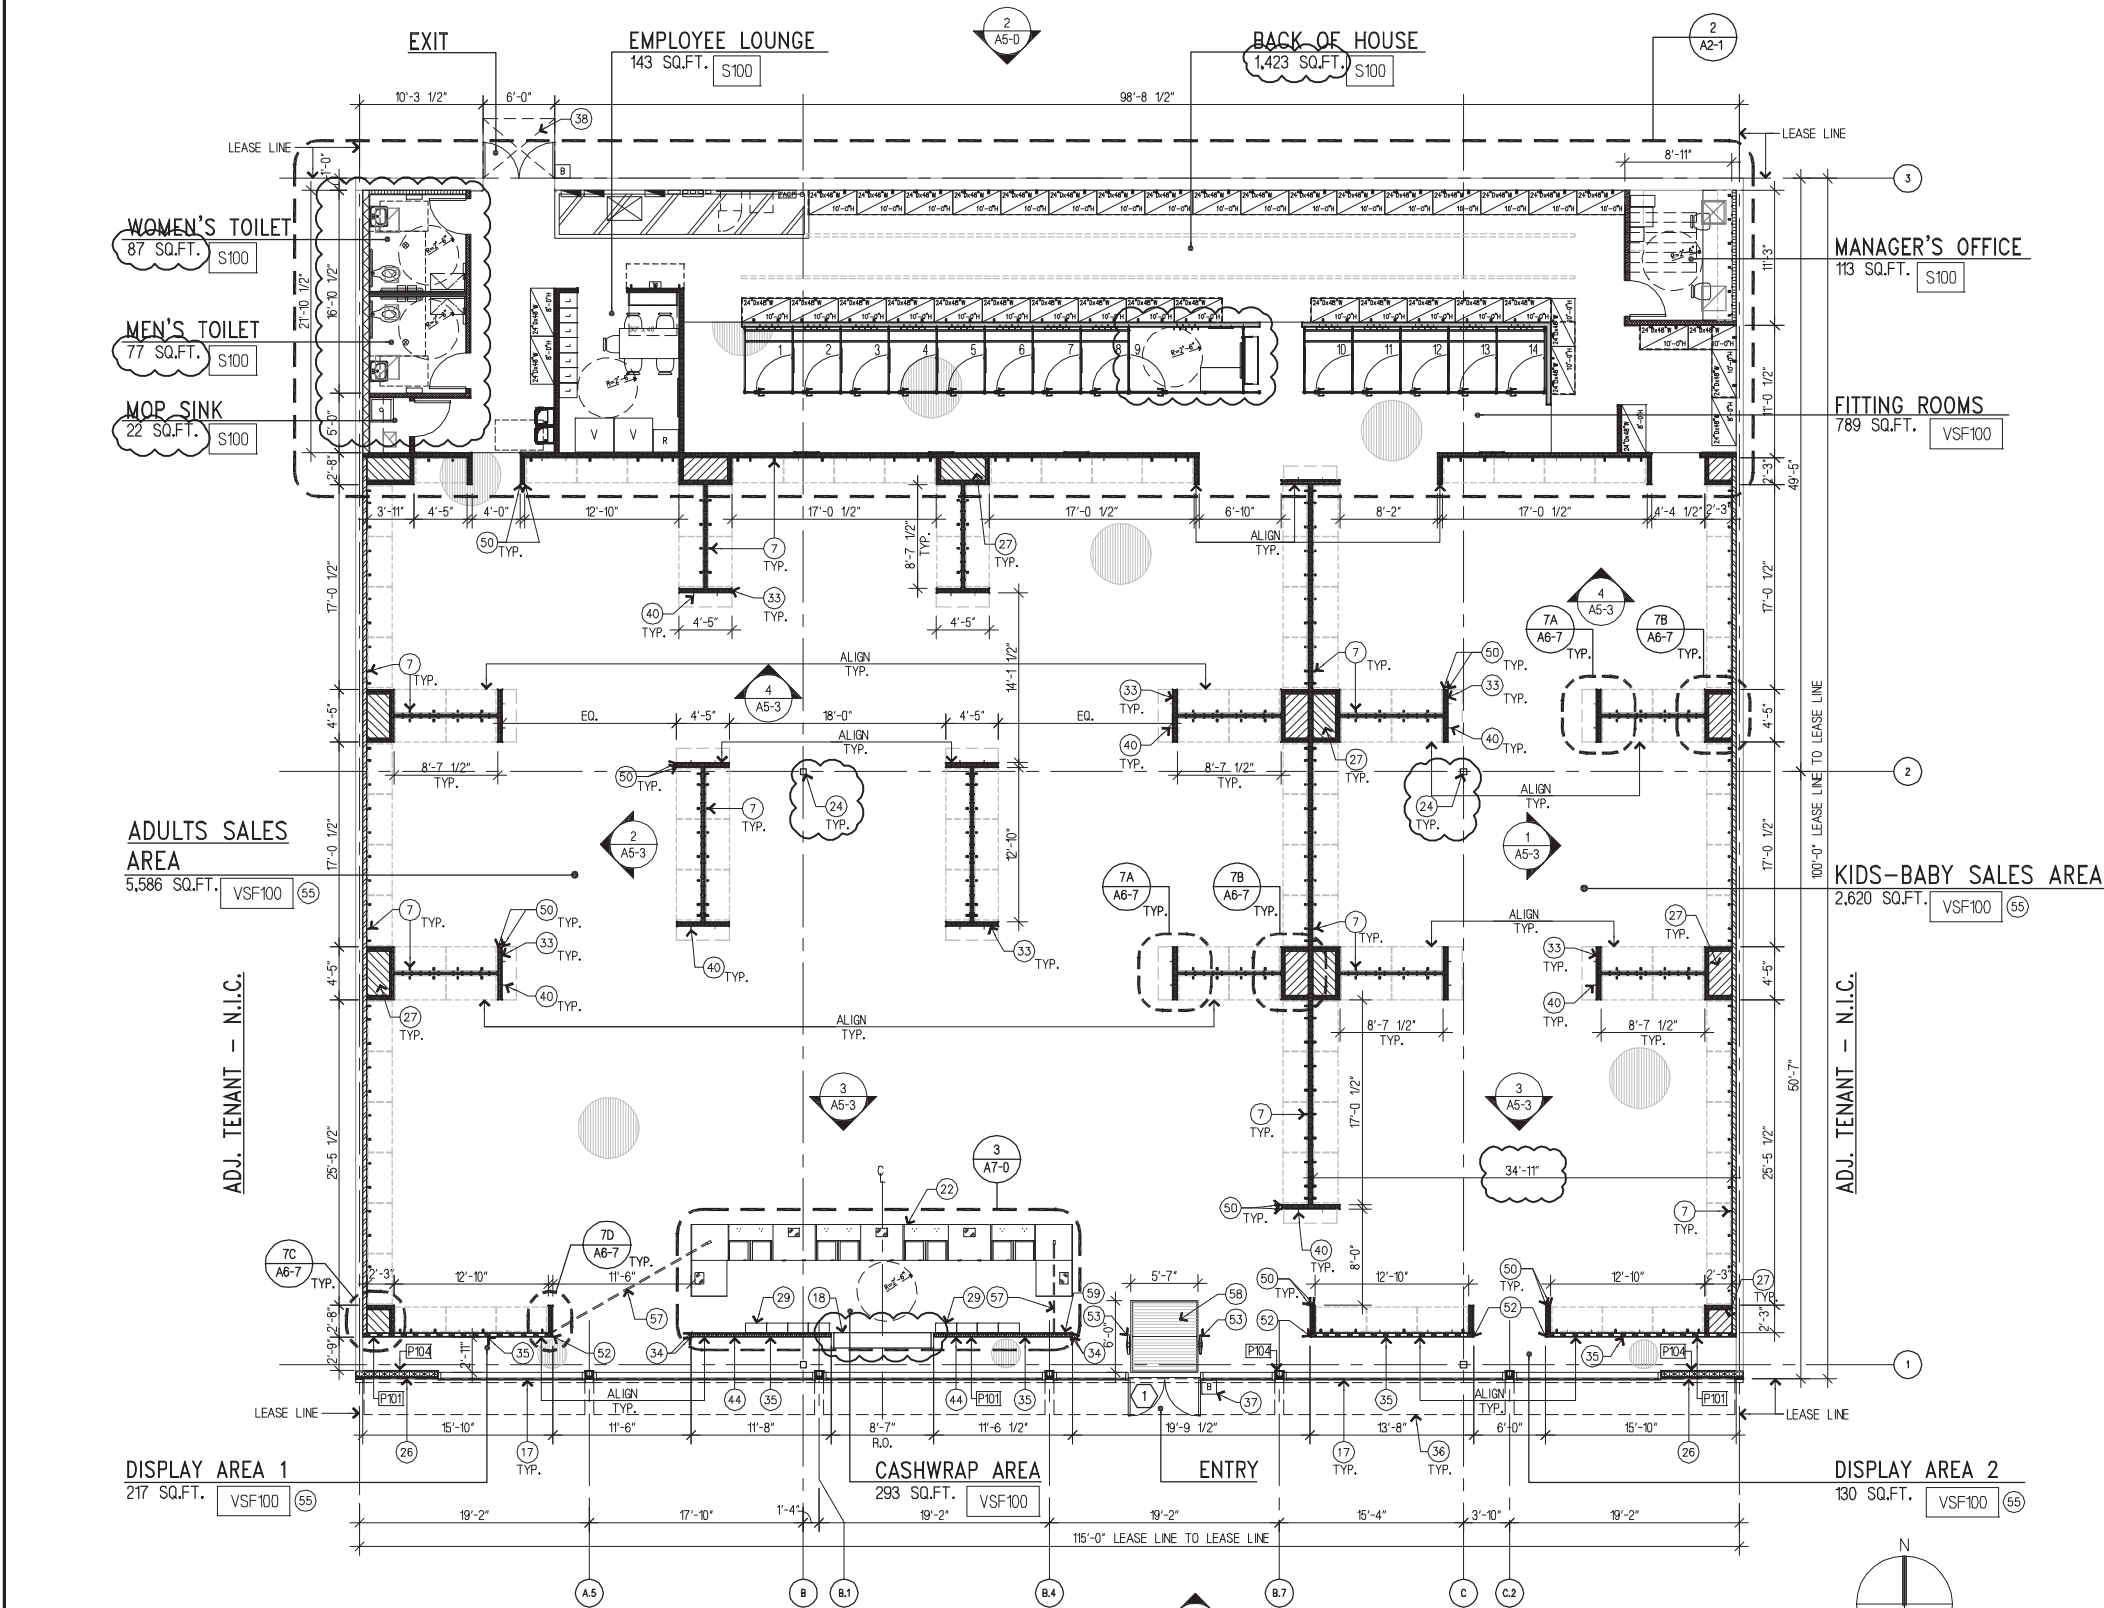

NOTES TO ARCHITECT:

- ISLAND WALL LOCATION DETERMINED BY VISUAL MERCHANDISING.
- CONFIRM LOCATION OF LUMI-SIGN W/ STORE DESIGN.
- FLOOR PLAN IS HYPOTHETICAL AND FOR ILLUSTRATIVE PURPOSES ONLY. REFER TO DESIGN SKETCHES FOR ACTUAL LAYOUT.
- MAINTAIN PROTOTYPICAL FITTING ROOM CONFIGURATION AND DOOR SWINGS FOR MANUFACTURING CONSISTENCY.
- FOR LOCATIONS REQUIRING VESTIBULE, SEE MODEL SPACE FOR VESTIBULE OPTION.


FLOOR PLAN

SCALE: 1/8" = 1'-0"


2

FLOOR PLAN KEY NOTES

1

| KEY | DESCRIPTION | DET./SHT. | NEW STORE |
|------|---|--------------------|---|
| (1) | 24" SHELVING ON STANDARDS AT BACK OF HOUSE (WHERE OCCURS) | 2/A6-2 | <div></div> <div>GAP INC. CORPORATE ARCHITECTURE 1 HARRISON STREET SAN FRANCISCO, CA. 94105</div> <div>STORE NO.: XXXX</div> <div>STORE NAME: XXXX</div> <div>STORE LOCATION: XXXXX</div> <div>GAP PROJ. I.D.: 00000XXXX</div> <div>PROTOTYPE DATE: 07/01/11</div> <div>OPENING 2012</div> |
| (2) | (2) 14" SHELVES ON STANDARDS AT MOP SINK | 1/A6-4 | |
| (3) | 14" SHELVING ON STANDARDS AT MANAGER'S OFFICE | 1/A6-4 | |
| (4) | UNISTRUT HANGROD @ 11'-0" A.F.F. | 12/A6-4b | |
| (5) | NOT USED | | |
| (6) | NOT USED | | |
| (7) | RECESSED STANDARDS @ PERIMETER WALLS & T-WALLS FROM 6" A.F.F. TO 8'-6" A.F.F., AT ISLAND WALLS FROM 6" A.F.F. TO 7'-6" A.F.F. | 12/A6-6 | |
| (8) | CHAIR RAIL AT ALL HIGH TRAFFIC AREAS FROM BOH TO SALES, MOUNT BOTTOM AT 2'-6" A.F.F., PAINT TO MATCH WALL | 9/A6-1 | |
| (9) | LOCKERS - INSTALL PER MANUFACTURER EACH TIER IS 18" L X 15" D X 72" H, WHERE OCCURS: INSTALL 24" SHELVING ABOVE FROM 6'-6" TO 2'-0" BELOW B.O. SPRINKLER HEAD ON SURFACE MOUNTED STANDARDS. | 3/A6-4 SIM. | |
| (10) | NOT USED | | |
| (11) | NETWORK RACK: 24" W X 32" H X 30" D: MOUNT TO TELEPHONE BACK BOARD WITH BOTTOM OF RACK AT 84" A.F.F., MINIMUM. | 6/A6-4 SEE ELEC. | <div>CONSULTANT INFO:</div> <div>PROFESSIONAL STAMP:</div> <div>ARCHITECT INFO:</div> <div>ISSUE TYPE:</div> <div>SCALE: AS NOTED</div> <div>DRAWN BY: XX/XX</div> <div>A&E JOB NO.: XXXX</div> <div>SHEET TITLE:</div> <div>FLOOR PLAN</div> <div>11,500 S.F. - VERSION</div> <div>SHEET NUMBER: A2-0</div> |
| (12) | REFRIGERATOR AND MICROWAVE (N.I.C.), PROVIDE DUPLEX OUTLET WITH SEPARATE DEDICATED CIRCUIT FOR EACH APPLIANCE | SEE ELEC. | |
| (13) | EMPLOYEE TIME CLOCK (24" SHELVING ABOVE ON SURFACE MOUNTED STANDARDS, WHERE OCCURS) | 3/4/A6-4 SEE ELEC. | |
| (14) | BULLETIN BOARD - OWNER FURNISHED, T.O. BOARD @ 6'-0" A.F.F. (24" SHELVING ABOVE ON SURFACE MOUNTED STANDARDS, WHERE OCCURS) | 3/A6-4 | |
| (15) | DRINKING FOUNTAIN, INSTALL PER MANUFACTURER'S SPECIFICATIONS AND LOCAL CODE - USE WATER RESISTANT GYP. BD. | 7/A6-5 SEE PLUMB. | |
| (16) | ELECTRICAL PANELS, INSTALL STRIPING ON THE FLOOR INDICATING MIN. 3'-0" CLEAR SPACE IN FRONT OF PANELS, PAINT (P107) PRIOR TO SEALING WITH (S100) | 67/A6-4 SEE ELEC. | |
| (17) | OLDCASTLE STOREFRONT SYSTEM | | |
| (18) | 8'-1" X 8'-1" LUMI SIGN | 5/A4-2b | |
| (19) | IF STOREFRONT SYSTEM BY MANUFACTURER, UNLESS OTHERWISE NOTED | | |
| (20) | NOT USED | | |
| (21) | PRE-FABRICATED FITTING ROOMS | 1/A6-2 | <div>CONSULTANT INFO:</div> <div>PROFESSIONAL STAMP:</div> <div>ARCHITECT INFO:</div> <div>ISSUE TYPE:</div> <div>SCALE: AS NOTED</div> <div>DRAWN BY: XX/XX</div> <div>A&E JOB NO.: XXXX</div> <div>SHEET TITLE:</div> <div>FLOOR PLAN</div> <div>11,500 S.F. - VERSION</div> <div>SHEET NUMBER: A2-0</div> |
| (22) | CASHWRAP | A7-0 | |
| (23) | MOP SINK, PROVIDE HOSE ON SPIGOT CUT TO 3'-0" LENGTH, WATER RESISTANT GYP. BD. TYP. AT ALL WALLS. | SEE PLUMB. | |
| (24) | (E) STRUCTURAL COLUMN PAINT (P101) BELOW (9'-6" A.F.F. (P104) ABOVE (9'-6" A.F.F. | 1/A0-4 | |
| (25) | NOT USED | | |
| (26) | RDS COMPOSITE PANEL SYSTEM, TYP. - WHERE (N) STOREFRONT SYSTEM OCCURS | 1/A5-0 | |
| (27) | GYP. BOARD LID AT VOID | 1/A6-7 | |
| (28) | PLATFORM DIVIDERS ABOVE MANAGER'S OFFICE | 3/A6-4b | |
| (29) | WALL MOUNTED HANGER TIGHTS @ CASHWRAP, PROVIDE BLOCKING | 1/A4-2b | |
| (30) | VENDING MACHINES (N.I.C.), PROVIDE SEPARATE DEDICATED CIRCUIT FOR EACH. | SEE ELEC. | |
| (31) | 10'-0" H HIGH DENSITY FIXED SHELVING WITH (2) ROWS OF 24" SHELVING ABOVE ON SURFACE MOUNTED STANDARDS (WHERE OCCURS) | 7/A6-4 | <div>CONSULTANT INFO:</div> <div>PROFESSIONAL STAMP:</div> <div>ARCHITECT INFO:</div> <div>ISSUE TYPE:</div> <div>SCALE: AS NOTED</div> <div>DRAWN BY: XX/XX</div> <div>A&E JOB NO.: XXXX</div> <div>SHEET TITLE:</div> <div>FLOOR PLAN</div> <div>11,500 S.F. - VERSION</div> <div>SHEET NUMBER: A2-0</div> |
| (32) | 10'-0" H HIGH DENSITY FIXED SHELVING WITH (1) ROW OF 24" SHELVING ABOVE ON SURFACE MOUNTED STANDARDS AT WALL BEHIND FITTING ROOMS (WHERE OCCURS) | 7/A6-4 SIM. | |
| (33) | T-WALLS & ISLAND WALLS: 5/8" GYP. BOARD ON METAL STUDS WITH RECESSED STANDARDS AT 24" O.C. | A6-6 | |
| (34) | STAINLESS STEEL CORNER GUARDS - 48"H A.F.F. TYP. | 2/A6-1 | |
| (35) | CHAIR RAIL (DOES NOT OCCUR AT PLATFORM) | 9A/A4-2a | |
| (36) | METAL CANOPY (OCCURS AT EXTERIOR LOCATIONS ONLY AS SPECIFIED BY STORE DESIGN) | | |
| (37) | DOOR BUZZER | SEE ELEC. | |
| (38) | MIN. 5'X5' LEVEL LANDING, MAX. 2% SLOPE REQUIRED AT EXIT DOORS. | | |
| (39) | DISPLAY AREA RAISED PLATFORM (WHERE OCCURS) | 5/A4-2b | |
| (40) | RECESSED STANDARDS AT 24" O.C. TYP. AT END PANEL | A6-6 | |
| (41) | COMPLETE SET OF AS-BUILT DRAWINGS IN PLASTIC TUBE SECURED TO WALL. SEND SECOND SET TO GAP PROJECT MANAGER. | SEE PLUMB. | <div>CONSULTANT INFO:</div> <div>PROFESSIONAL STAMP:</div> <div>ARCHITECT INFO:</div> <div>ISSUE TYPE:</div> <div>SCALE: AS NOTED</div> <div>DRAWN BY: XX/XX</div> <div>A&E JOB NO.: XXXX</div> <div>SHEET TITLE:</div> <div>FLOOR PLAN</div> <div>11,500 S.F. - VERSION</div> <div>SHEET NUMBER: A2-0</div> |
| (42) | NOT USED | | |
| (43) | 48" L X 12" H HANGROD @ EMPLOYEE LOUNGE FOR COATS - MOUNT AT 4'-0" A.F.F. BLOCK AS REQUIRED (SHELVING ABOVE ON SURFACE MOUNTED STANDARDS) | 3/A6-4 SIM. | |
| (44) | 48" H DISPLAY WALL BEHIND CASHWRAP | 12/A4-2b | |
| (45) | 8'-0" H HIGH DENSITY FIXED SHELVING AT 9'-6" WALLS | 7/A6-4 SIM. | |
| (46) | ACCESSIBLE LOCKER W/KEY PAD LOCK @ 40" A.F.F., MAX. | | |
| (47) | RELOCATE EXISTING W/ SALVAGED WINDOW SYS. FROM IN DOOR LOCATION (WHERE OCCURS) | | |
| (48) | FLOORING TRANSITION - VINYL TO CONCRETE | 8/A6-1 | |
| (49) | SAW-CUT/ CORE DRILL AND PATCH FLOOR SLAB AS REQUIRED FOR SANITARY | 1/A6-5 SEE PLUMB. | |
| (50) | (2) 1/4" X 7/8" MITERED WOOD TRIM (P101) AT GYP. BOARD CORNERS THROUGHOUT UNLESS S.S. CORNER GUARDS ARE SPECIFIED | 11/A6-6 | |
| (51) | NOT USED | | <div>CONSULTANT INFO:</div> <div>PROFESSIONAL STAMP:</div> <div>ARCHITECT INFO:</div> <div>ISSUE TYPE:</div> <div>SCALE: AS NOTED</div> <div>DRAWN BY: XX/XX</div> <div>A&E JOB NO.: XXXX</div> <div>SHEET TITLE:</div> <div>FLOOR PLAN</div> <div>11,500 S.F. - VERSION</div> <div>SHEET NUMBER: A2-0</div> |
| (52) | STAINLESS STEEL CORNER GUARDS - 96" A.F.F. TYP. | 2/A6-1 | |
| (53) | EAS SYSTEM FLOOR MOUNTED PEDESTALS | 1/A4-5 SEE ELEC. | |
| (54) | (4) 2'-0" X 4'-9" FITTING ROOM AREA MIRROR PROVIDED BY VENDOR - MOUNT BOTTOM AT 18" A.F.F. PROVIDE BLOCKING AS REQUIRED. | 11/A6-0 | |
| (55) | 1 X 6 WOOD TRIM AT SALES AREA (PERIMETER WALLS, T-WALLS), DISPLAY AREA, AND FITTING ROOMS. PAINT (P101), T.O. TRIM @ 9'-6" A.F.F. | A6-6 | |
| (56) | PHONE AND VOLUME CONTROL FOR FITTING ROOMS | SEE ELEC. | |
| (57) | SAW-CUT/ CORE DRILL AND PATCH FLOOR SLAB AS REQUIRED FOR CONDUIT. | A7-0 SEE ELEC. | |
| (58) | 6'-0" L X 5'-7" W ENTRANCE WALK-OFF MAT, INSTALL SO THAT RAIL IS PERPENDICULAR TO TRAFFIC, USE AT EXTERIOR LOCATIONS ONLY | 4/A6-5 | |
| (59) | VOLUME CONTROL FOR SALES | SEE ELEC. | |
| (60) | VOLUME CONTROL FOR BACK OF HOUSE | SEE ELEC. | |
| (61) | ALL DIMENSIONS TO FACE OF FINISH OR CENTERLINE OF COLUMN U.O.N. | | <div>CONSULTANT INFO:</div> <div>PROFESSIONAL STAMP:</div> <div>ARCHITECT INFO:</div> <div>ISSUE TYPE:</div> <div>SCALE: AS NOTED</div> <div>DRAWN BY: XX/XX</div> <div>A&E JOB NO.: XXXX</div> <div>SHEET TITLE:</div> <div>FLOOR PLAN</div> <div>11,500 S.F. - VERSION</div> <div>SHEET NUMBER: A2-0</div> |
| (62) | REFER TO SHEET A2-1 FOR ENLARGED FLOOR PLANS | | |
| (63) | REFER TO SHEET A0-1 FOR RESPONSIBILITY MATRIX | | |
| (64) | REFER TO SHEET A0-4 FOR FINISH SCHEDULE | | |
| (65) | REFER TO SHEET A0-2 FOR DOOR SCHEDULE | | |
| (66) | REFER TO SHEET A2-1 FOR WALL TYPES | | |
| (67) | RELOCATE EXISTING AND FURNISH AND INSTALL NEW FIRE EXTINGUISHERS PER LOCAL CODE REQUIREMENTS, VERIFY LOCATION AND QUANTITIES WITH LIFE SAFETY INSPECTOR. | | |
| (68) | | | |
| (69) | | | |
| (70) | | | |

ARCHITECT TO MAINTAIN THE
PROTOTYPICAL FITTING ROOM
LAYOUT FOR MANUFACTURING
CONSISTENCY

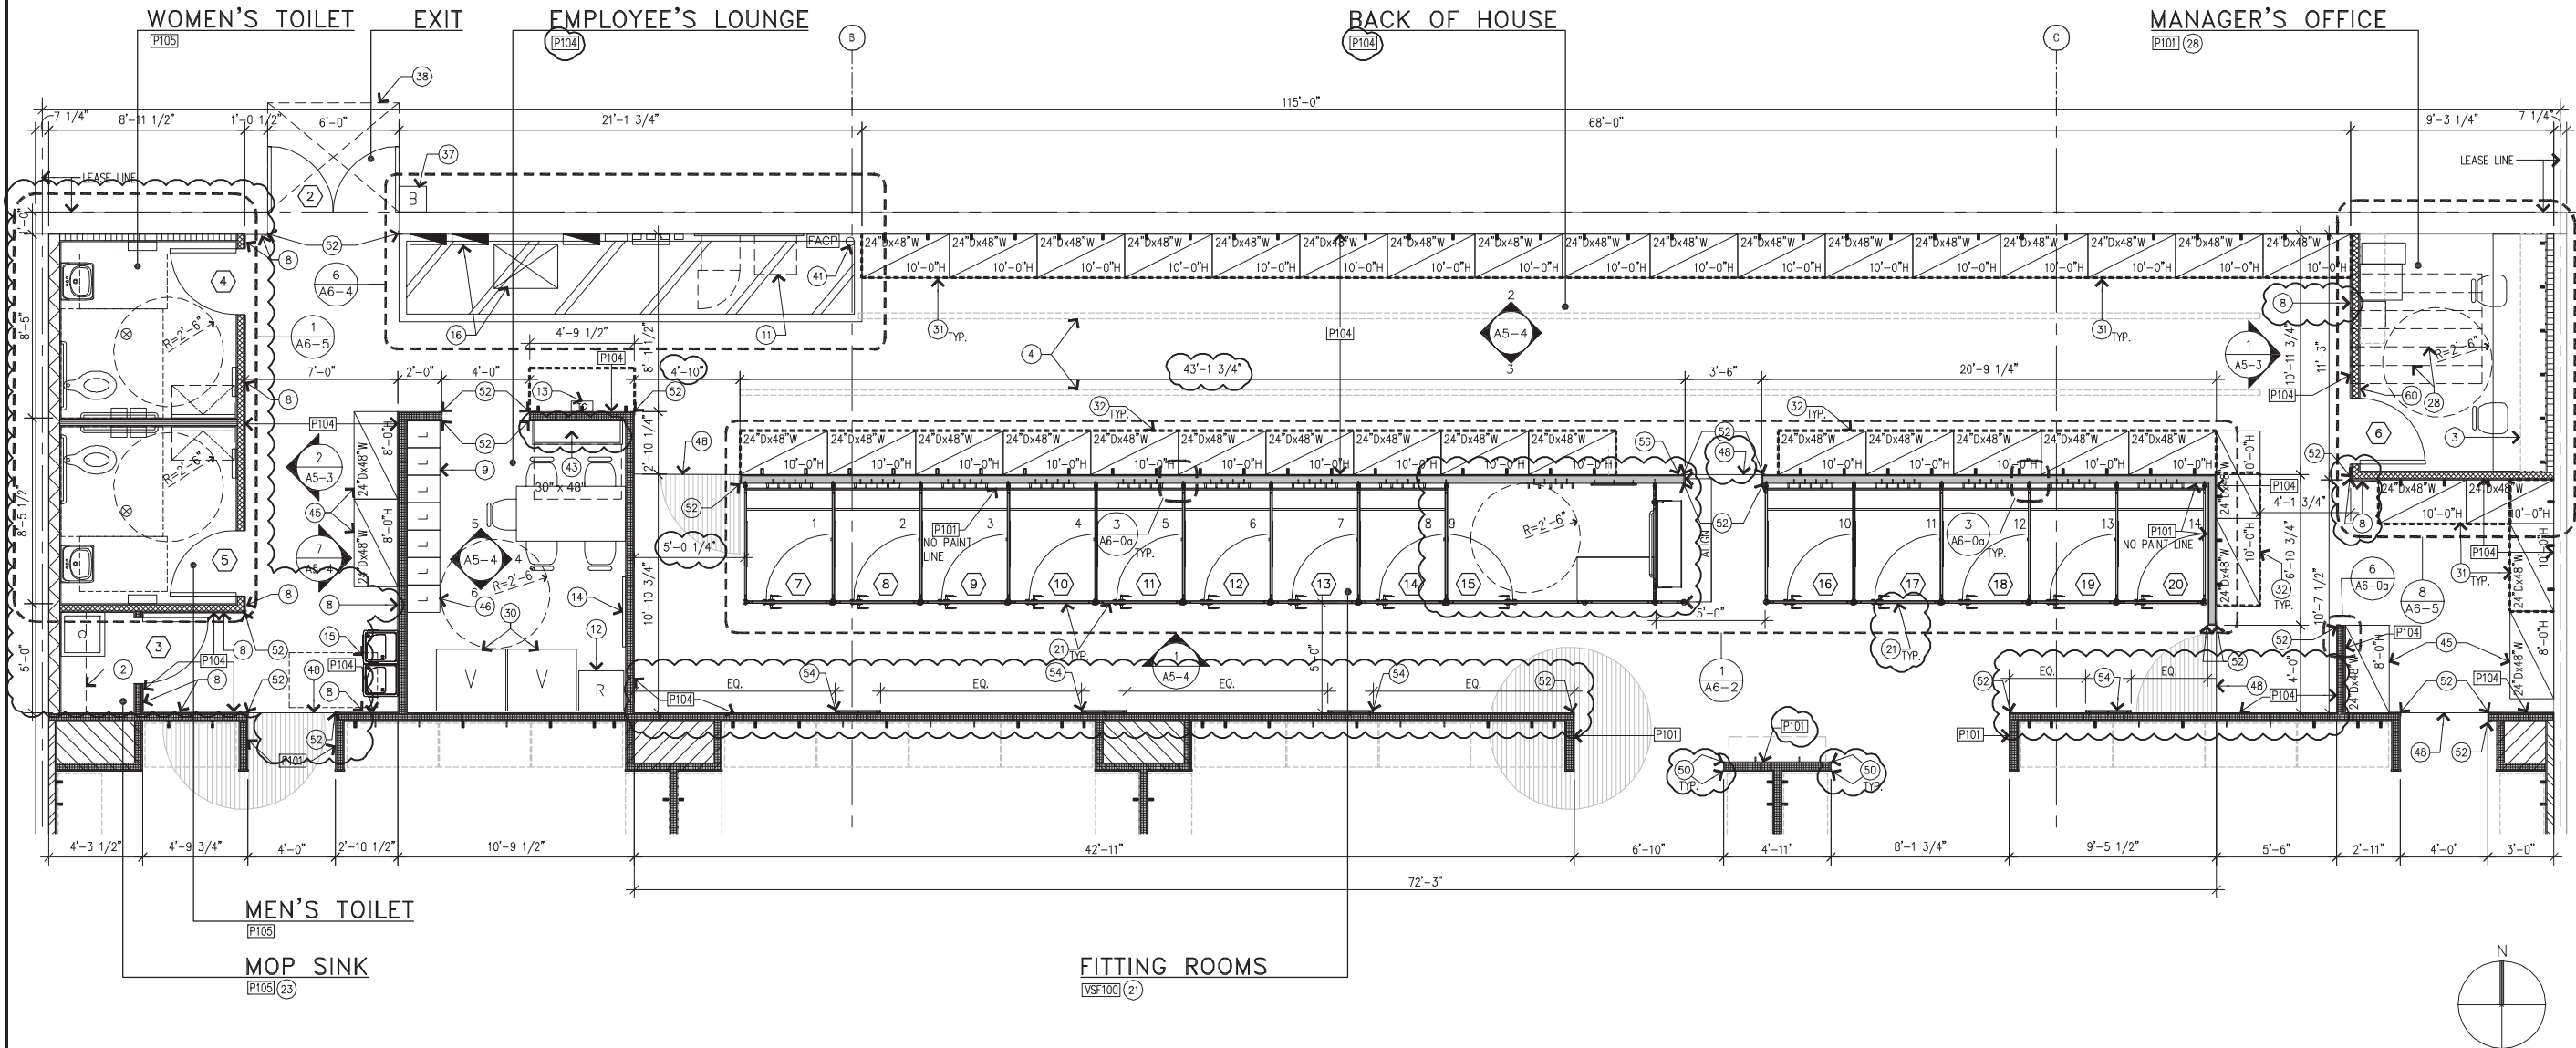

ENLARGED FLOOR PLAN

SCALE:
1/4" = 1'-0"

2

ARCHITECT/ENGINEER TO DETERMINE
SPACE AND GAGE OF METAL STUDS
WHEN WALLS ARE HIGHER THAN
20'-0" A.F.F.

FLOOR FINISH LEGEND

3

WALL TYPES AND GENERAL NOTES

- EXISTING WALL TO REMAIN. PATCH OR FURR AS REQUIRED TO RECEIVE NEW FINISHES.
- 2
A6-0
SIM. NEW NON-RATED PARTITION WALL TO 12'-6" A.F.F. = 3 5/8" 20-GA. METAL STUDS AT 12" O.C. WITH 5/8" GYP. BD. BOTH SIDES AS DETAILED. AT FITTING ROOM PANEL ATTACHMENT TO WALL PROVIDE BACK TO BACK STUDS AS DETAILED.
- 2, 8
A6-0 NEW NON-RATED FULL HEIGHT WALL TO UNDERSIDE OF DECK WITH RECESSED OR SURFACE MOUNTED STANDARDS FOR SHELVEING = 3 5/8" 16-GA. METAL STUDS AT 12" O.C. WITH 5/8" GYP. BD. BOTH SIDES.
- 1
A6-0 OTHER NON-RATED FULL HEIGHT WALL TO UNDERSIDE OF DECK = 3 5/8" 16-GA. METAL STUDS AT 16" O.C. WITH 5/8" GYP. BD. BOTH SIDES AS DETAILED. USE 5/8" MOISTURE RESISTANT GYP. BD. AT TOILET ROOM SIDE, DRINKING FOUNTAIN SIDE AND MOP SINK SIDE.
- 1
A6-0 NEW FURRED FULL HEIGHT WALLS WITH RECESSED STANDARDS = DBL 3 5/8" 18 GA. MTL. STUDS AT 24" O.C. W/ 5/8" GYP. BD. ON ONE SIDE O/ EXISTING RATED WALL.
- 8
A6-0 OTHER FURRED FULL HEIGHT WALLS = 3 5/8" 20 GA. MTL. STUDS AT 24" O.C. W/ 5/8" GYP. BD. ON ONE SIDE O/ EXISTING RATED WALL.
- 8
A6-0 NEW PLUMBING WALL = 6" 20-GA. METAL STUDS IN SINGLE TOILET (8" 20-GA. METAL STUDS IN MULTIPLE TOILET) AT 24" O.C. WITH 5/8" WATER RESISTANT GYP. BD. AT RESTROOM SIDE AND 5/8" GYP. BD. AT NON-RESTROOM SIDE EXTEND TO UNDERSIDE OF STRUCTURE.

ARCHITECT TO USE APPLICABLE
INFORMATION ONLY. HATCH OUT
REMAINING FIELDS

NOTES

- MAX. HEIGHT REPRESENTS MAXIMUM HEIGHT PERMITTED FOR A STUD WALL WITHOUT USING DIAGONAL BRACING. SEE 6A/A6-0 AND 6B/A6-0 FOR BRACING REQUIREMENTS FOR WALLS TALLER THAN MAX. HEIGHT ALLOWANCE.
- REFER TO SHEET A6-0 & A6-0a FOR PARTITION DETAILS AND STUD FRAMING NOTES.
- BLOCKING REQUIREMENT: PROVIDE BLOCKING AT ALL WALL-MOUNTED ITEMS. SEE DETAIL 11/A6-0
- R-11 BATT INSULATION AT ALL OFFICE AND RESTROOM WALLS, U.O.N.
- REFER TO SPECIFICATIONS, MECHANICAL, PLUMBING, AND ELECTRICAL SHEETS FOR PROJECT REQUIREMENTS AND SCOPE.
- REFER TO SHEET A0-1 FOR RESPONSIBILITY MATRIX
- REFER TO SHEET A0-2 FOR DOOR SCHEDULE
- REFER TO SHEET A0-4 FOR FINISH SCHEDULE
- ALL DIMENSIONS TO FACE OF FINISH OR CENTERLINE OF COLUMN U.O.N.
- FURNISH AND INSTALL FIRE EXTINGUISHERS PER LOCAL CODE REQUIREMENTS. VERIFY LOCATIONS & QUANTITIES WITH LIFE SAFETY INSPECTOR.

SEE A2-0 FOR KEYNOTES

NEW STORE



GAP INC.
CORPORATE ARCHITECTURE
1 HARRISON STREET
SAN FRANCISCO, CA. 94105

STORE NO.: XXXX

STORE NAME:
XXXX

STORE LOCATION:
XXXXX

GAP PROJ. I.D.: 0000XXXXX

PROTOTYPE DATE:
07/01/11
OPENING 2012

CONSULTANT INFO:

PROFESSIONAL STAMP:

ARCHITECT INFO:

ISSUE TYPE:

SCALE: AS NOTED

DRAWN BY: XX/XX

A&E JOB NO.: XXXX


SHEET TITLE:

ENLARGED FLOOR PLANS

11,500 OPTION

SHEET NUMBER:

A2-1

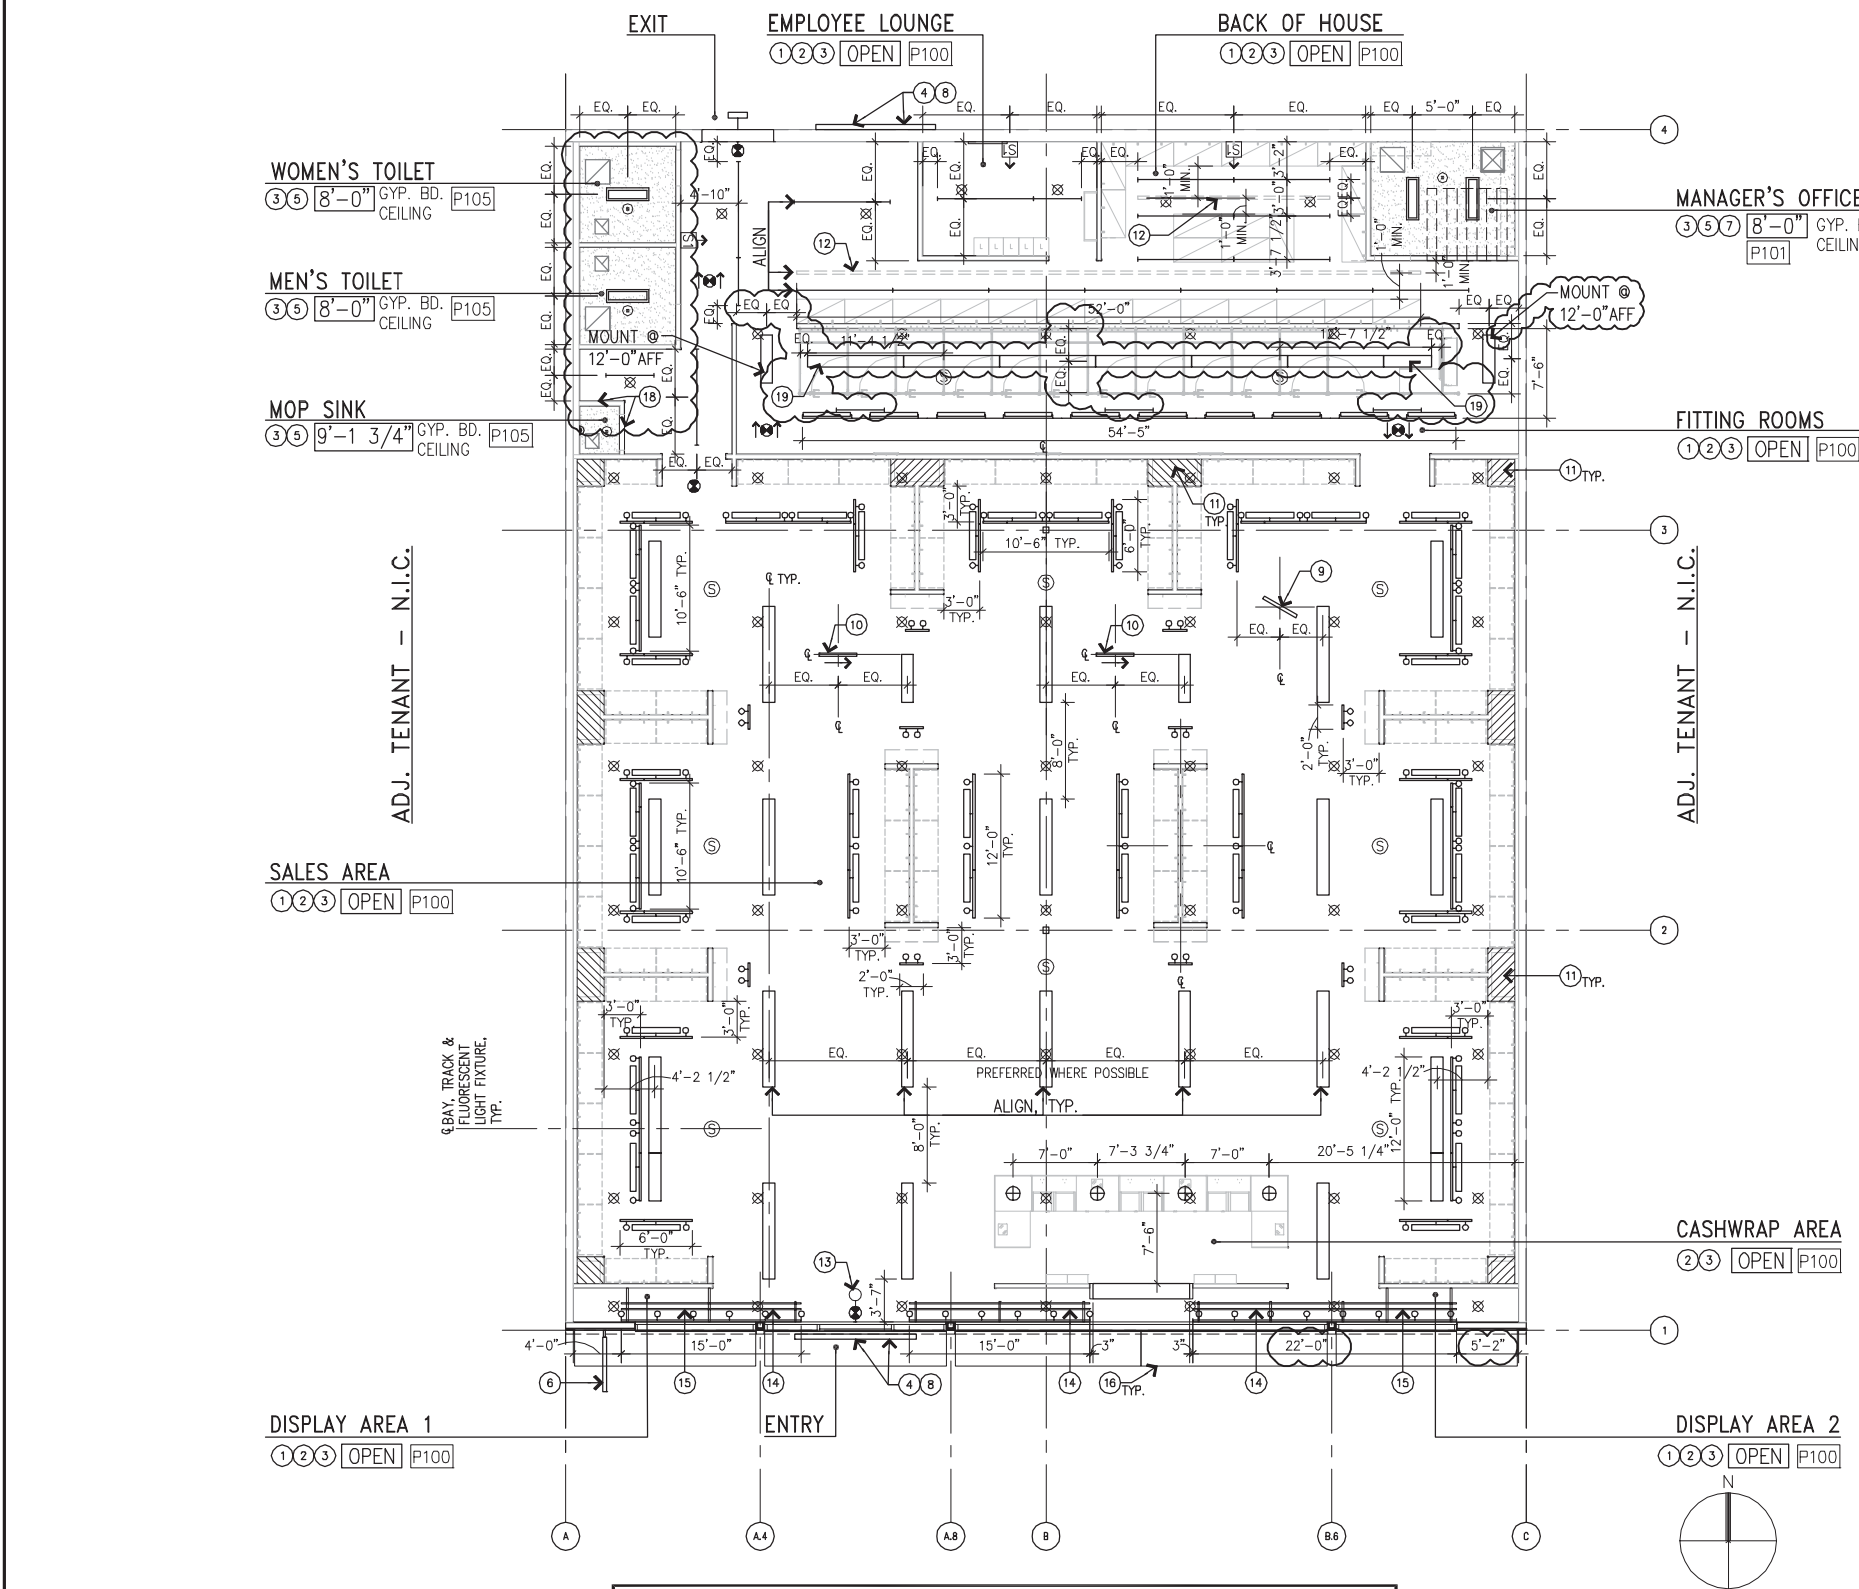

NOTE TO ARCHITECT:
UNISTRUT HANGRODS SHOULD BE
A MINIMUM OF 1'-0" AWAY FROM
FACE OF FIXED SHELVING UNITS.

NOTES TO ARCHITECT:
1. LIGHTING DESIGN SHOWN IS COMPLIANT WITH IECC 2009. IT IS THE RESPONSIBILITY OF THE ARCHITECT TO ENSURE LIGHTING IS CODE COMPLIANT FOR YOUR JURISDICTION. LIGHTING CALCULATIONS AND COMPLIANCY TO BE COMPLETED DURING DDS. IT IS THE RESPONSIBILITY OF THE ARCHITECT TO RECEIVE STORE DESIGN APPROVAL PRIOR TO MODIFYING TEMPLATE LIGHTING CONDITIONS.
2. FOR LOCATIONS REQUIRING VESTIBULE, SEE MODEL SPACE FOR VESTIBULE OPTION.

SEE 9/A4-3 FOR MOUNTING HEIGHTS AND ELECTRICAL DWGS. FOR FIXTURE SCHEDULE & ADDITIONAL NOTES

| | |
|--|--|
| 4 FT. OR 8 FT. FLOOR STRIP FIXTURE W/ SINGLE TUBE @ 13'-0" A.F.F. @ BOH | |
| 1 X 8 FLUORESCENT FIXTURE W/ 2 TUBES AND SHIMMERS @ 12'-0" A.F.F. AT SALES FLOOR, @ 10'-0" A.F.F. AT FITTING ROOMS, U.O.N. | |
| 1 X 4 FLUORESCENT FIXTURE W/ 2 TUBES AND SHIMMERS @ 12'-0" A.F.F. AT SALES FLOOR, @ 10'-0" A.F.F. AT FITTING ROOMS, U.O.N. | |
| 4FT FLUORESCENT STRIP FIXTURE W/ SINGLE TUBE AND EMERGENCY BACKUP MOUNTED AT 1'-0" ABOVE TRACK OF FITTING ROOM GRAPHICS | |
| 1 X 4 SURFACE MOUNTED FLUORESCENT FIXTURE WITH ACRYLIC DIFFUSER @ MANAGER'S OFFICE AND TOILET ROOMS | |
| ILLUMINATED EXIT SIGN-WALL MOUNTED PREFERRED, SUSPEND FROM STRUCTURE WHERE REQUIRED | |
| FLUORESCENT WALL WASHER TRACK HEADS MOUNTED ON SINGLE CIRCUIT TRACK. MOUNT BOTTOM OF TRACK AT 13'-0" A.F.F. FOR 16'-0" FITTING ROOM GRAPHICS | |
| FLUORESCENT WALL WASHER TRACK HEADS MOUNTED ON SINGLE CIRCUIT TRACK. MOUNT BOTTOM OF TRACK AT 13'-0" A.F.F. FOR 14'-0" FITTING ROOM GRAPHICS | |
| FLUORESCENT WALL WASHER TRACK HEADS MOUNTED ON SINGLE CIRCUIT TRACK. MOUNT BOTTOM OF TRACK AT 13'-0" A.F.F. FOR 12'-0" FITTING ROOM GRAPHICS | |
| 14" ACRYLIC GLOBE PENDANT LIGHTS: CASHWRAP, MOUNT BOTTOM AT 8'-6" A.F.F. | |
| PORCELAIN SOCKET FIXTURE WITH PULL CHAIN SWITCH. (MOP SINK) | |
| TRACK HEADS AT 3'-0" O.C. ON TRACK SURFACE MOUNTED @ DISPLAY WINDOW | |
| UNISTRUT HANG ROD AT 11'-0" A.F.F. | |
| PENDANT MOUNTED LIGHT TRACK WITH LINE VOLTAGE FIXTURE TRACK LIGHT - 12'-0" A.F.F. TO BOTTOM OF TRACK | |
| PENDANT MOUNTED MUSIC SPEAKERS @ 13'-0" A.F.F. | |
| SURFACE MOUNTED SPEAKERS @ 13'-0" A.F.F. | |
| DOUBLE ROW OF POSTER TRACK ON BRACKET, PAINT BRACKET TO MATCH WALL FINISH | |
| TOILET ROOM EXHAUST FAN, SEE MECH. | |
| CEILING SUPPLY AIR REGISTER, SEE MECH. | |
| CEILING RETURN AIR REGISTER, SEE MECH. | |
| (E) EXTERIOR LIGHTS BY LANDLORD | |
| BRONZE UPRIGHT SPRINKLER HEAD | |
| RECESSED SPRINKLER HEAD | |
| VESTIBULE DOWNLIGHT AT LOCATIONS REQUIRING VESTIBULE ONLY, TYP. OF 12 | |

CEILING LEGEND

| KEY | DESCRIPTION | DET./SHT. |
|-----|--|----------------------|
| ① | FIRE ALARM / STROBE - AUDIO/VISUAL ALARM TO ADA REQUIREMENTS. MOUNT/ SUSPEND ALARM AS TO NOT INTERFERE WITH 10'-0" HIGH DISPLAY FIXTURES. | |
| ② | EXPOSED ROOF STRUCTURE / DECK, DUCTWORK, UNISTRUTS, CONDUIT, J-BOXES, SPRINKLER PIPING, LIGHT FIXTURE HANGERS, ETC. - PAINT [P100] ABOVE 9'-6" A.F.F. | |
| ③ | SPRINKLER HEAD LAYOUT TO CONFORM TO CODE, TAKING INTO ACCOUNT LOCATIONS OF DUCTWORK, LIGHTING, AND LOCATION OF 10'-0" HIGH SHELVING UNITS. | SEE MECH. |
| ④ | LOCATION OF POWER STUB AT JOIST LEVEL TO TENANT'S ILLUMINATED STOREFRONT SIGNAGE (AT ALL SIGN LOCATIONS), WIRED BACK TO 24-HOUR TIME CLOCK ADJACENT TO ELECTRICAL PANELS IN STOCKROOM. | SEE ELEC. |
| ⑤ | GYP. BD. CEILING | |
| ⑥ | BLADE SIGN | 9/A4-1a |
| ⑦ | PLATFORM DIVIDERS ABOVE MANAGER'S OFFICE - FOR WALL FRAMING SEE A2-1 AND B/6-0 FOR CEILING FRAMING | 3/A6-4b |
| ⑧ | EXTERIOR ILLUMINATED SIGNAGE | 1/A4-1a |
| ⑨ | HANGING FITTING ROOM SIGN W/O ARROW | 6/A4-1b |
| ⑩ | HANGING FITTING ROOM SIGN W/ARROW | 3/A4-1b |
| ⑪ | GYP. BOARD LID AT VOID | 1/A6-7 |
| ⑫ | UNISTRUT HANGROD AT 11'-0" A.F.F. | 1,2,4/A6-4b |
| ⑬ | TRAFFIC COUNTER - GC TO SUPPLY & INSTALL L-BRACKET PAINT TO MATCH WALL. | 1/A4-2a SEE ELEC. |
| ⑭ | DOUBLE ROW OF POSTER TRACK ON L-BRACKET @ 6'-0" O.C. (8'-0" O.C. MAX.), PAINT BRACKET TO MATCH WALL FINISH | 1,2/A4-2b |
| ⑮ | DOUBLE ROW OF POSTER TRACK ON TUBE STEEL SUPPORTS @ 6'-0" O.C. (8'-0" O.C. MAX.) PAINT TUBE STEEL SUPPORTS TO MATCH WALL FINISH | 5,8/A4-2a |
| ⑯ | METAL CANOPY (OCCURS AT EXTERIOR LOCATIONS ONLY AS SPECIFIED BY STORE DESIGN) | A5-0 |
| ⑰ | KIDS & BABY BLADE SIGN (WHERE OCCURS) | 10/A4-1b |
| ⑱ | MOP SINK - NO STORAGE AT PLATFORM SIGN ABOVE DOOR | 11/A4-1b |
| ⑲ | LIGHTS AT FITTING ROOMS- EXTEND AT LEAST HALF WAY OVER END FITTING ROOM. | |

CEILING KEY NOTES

- ALL DIMENSIONS FOR LOCATING FIXTURES ARE FROM FACE OF WALL FINISH TO CENTERLINE OF FIXTURE U.O.N.
- ALL HEIGHTS INDICATED ON PLANS ARE FROM TOP OF FINISHED FLOOR TO BOTTOM OF CEILING/FIXTURE SPECIFIED U.O.N.
- PROVIDE ADEQUATE CLEARANCES FOR FIXTURES, DUCTS, CEILING ITEMS NECESSARY TO MAINTAIN THE SPECIFIED HEIGHTS ABOVE FINISHED FLOOR.
- ARCHITECTURE DRAWINGS DETERMINE LOCATION OF LUMINAIRES AND SUPERSEDE ALL OTHER DRAWINGS U.O.N.
- SEE ELECTRICAL DRAWINGS FOR FIXTURE MODEL NUMBER AND QUANTITIES.
- ALL LIGHTING FIXTURES FURNISHED BY GAP PURCHASING, INSTALLED BY ELECTRICAL SUBCONTRACTOR, U.O.N.
- ADDITIONAL HANGER & SAFETY WIRES FOR LIGHT FIXTURES, SPEAKERS, AND AIR SUPPLY/ RETURN DIFFUSERS (AS REQ'D. PER LOCAL CODES) TO BE THE RESPONSIBILITY OF THE CONTRACTOR.
- SEE MECHANICAL DRAWINGS FOR HVAC SYSTEM MODIFICATIONS. ARCHITECTURAL DRAWING LUMINAIRE LOCATIONS SUPERSEDES ALL OTHER CEILING APPURTENANCES.
- SEE FINISH SCHEDULE SHEET A0-4 FOR FINISHES.
- FOR TYPICAL MOUNTING HEIGHT FOR OVERHEAD ELECTRICAL FIXTURES, SEE 3/-.

GAP INC.
CORPORATE ARCHITECTURE
1 HARRISON STREET
SAN FRANCISCO, CA. 94105

STORE NO.: XXXX

STORE NAME: XXXX

STORE LOCATION: XXXXX

GAP PROJ. I.D.: 00000XXXXX

PROTOTYPE DATE: 07/01/11

OPENING 2012

CONSULTANT INFO:

PROFESSIONAL STAMP:

ARCHITECT INFO:

ISSUE TYPE:

SCALE: AS NOTED

DRAWN BY: XX/XX

A&E JOB NO.: XXXX

SHEET TITLE: REFLECTED CEILING PLAN

8,000 S.F. - VERSION

SHEET NUMBER:

A3-0