


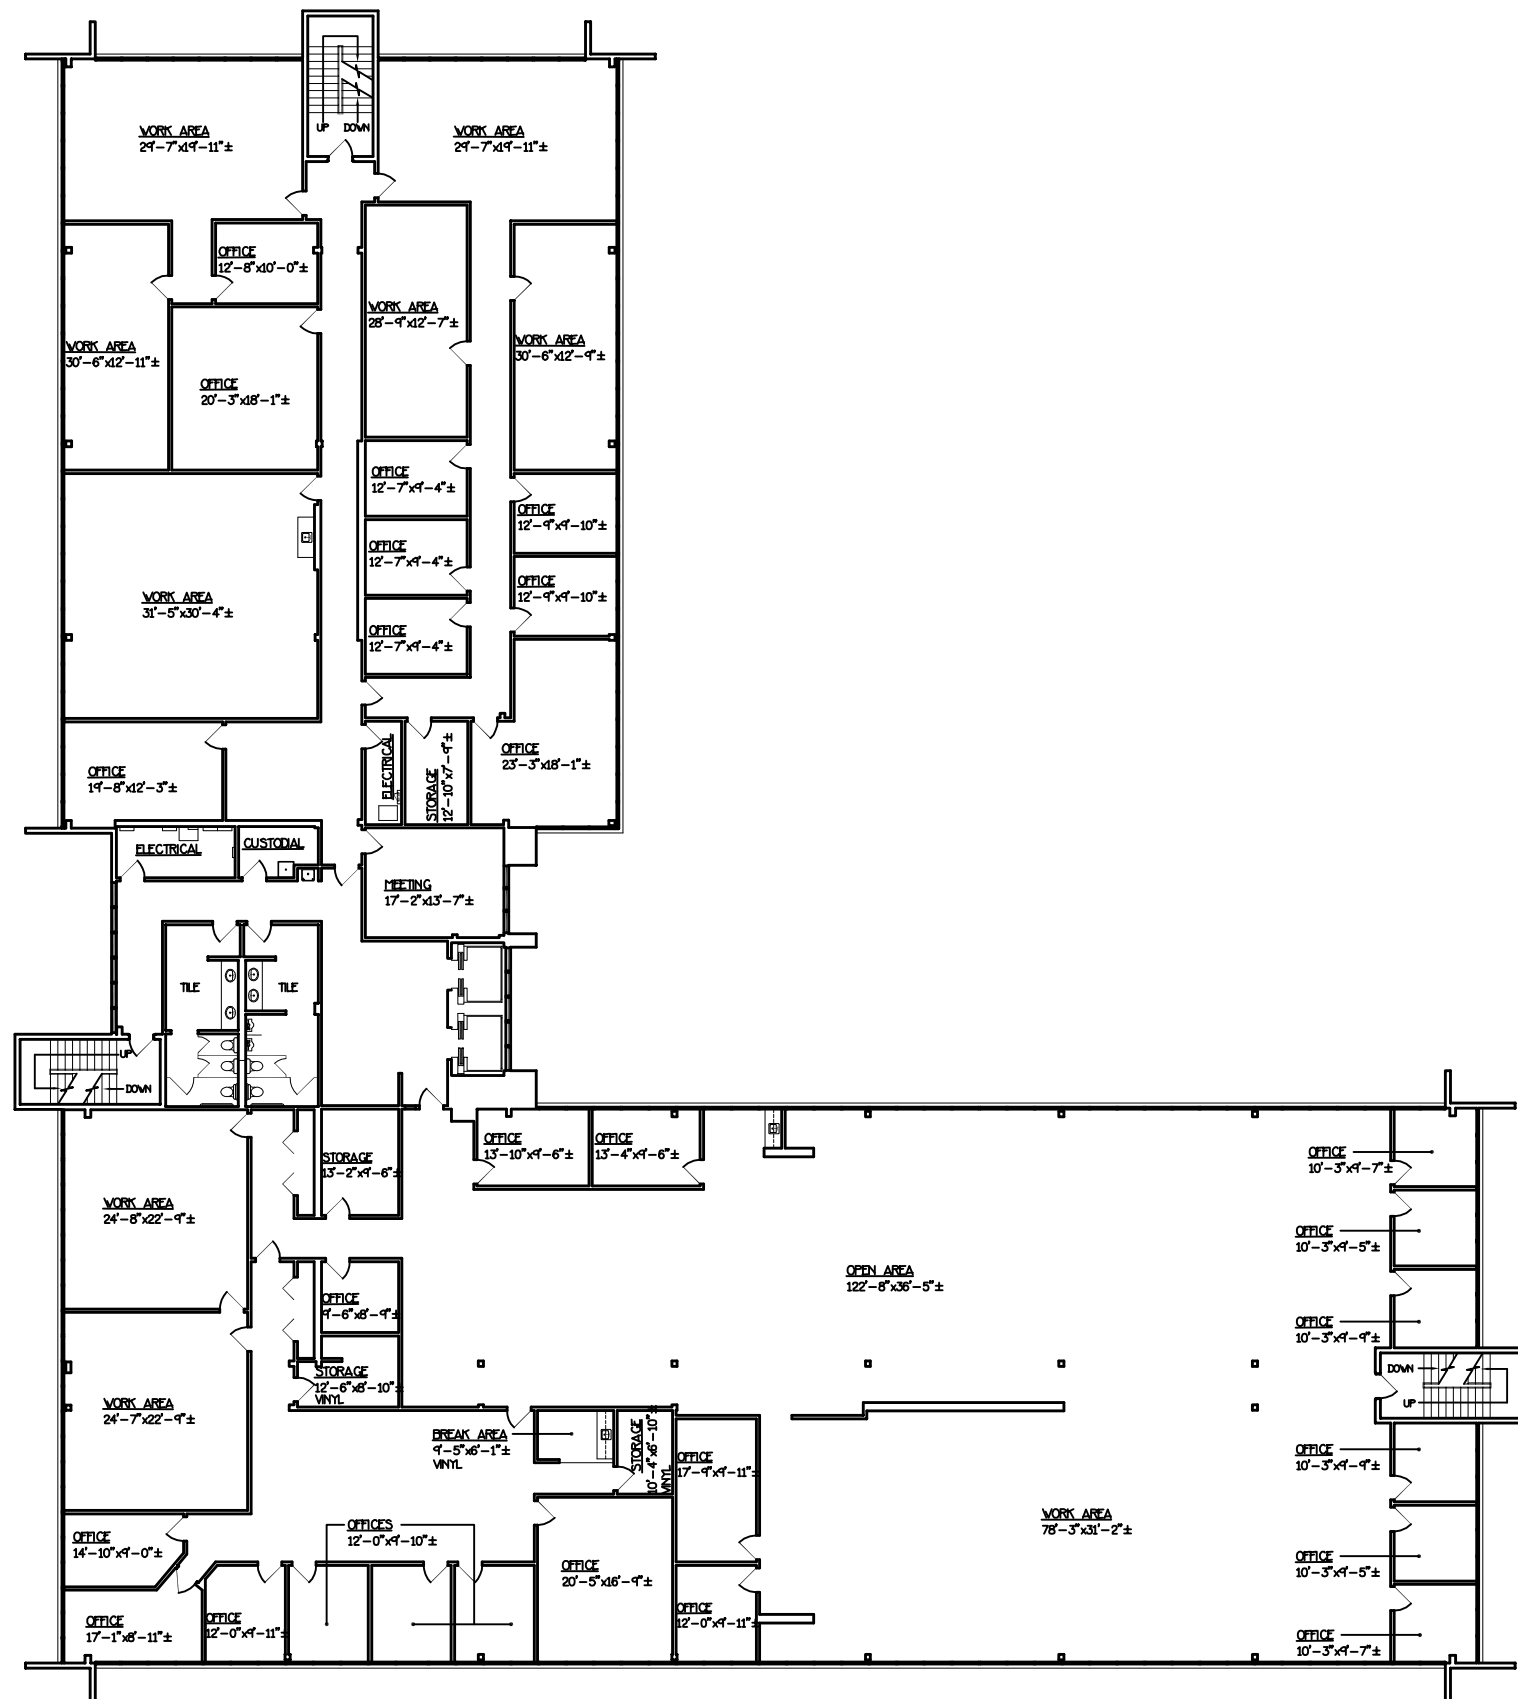

THIRD FLOOR

NOTES

1. ALL CALCULATIONS INDICATE "USABLE" AREA AS PER "BOMA" STANDARDS.
2. ALL FIXTURES INDICATED ARE BUILT-IN.
3. ALL FLOORS ARE CARPET UNLESS OTHERWISE INDICATED.
4. ALL CEILING HEIGHTS ARE 8'-0" UNLESS OTHERWISE NOTED.
5. ALL DIMENSIONS TO BE FIELD VERIFIED PRIOR TO ANY CONSTRUCTION.
6. CALCULATIONS EXCLUDE ALL VERTICAL PENETRATIONS AND STAIR WELLS.

AREA CALCULATIONS:

THIRD FLOOR AREA 19,788.07 SQ. FT.



SCALE	DATE
3/32"=1'-0"	01/17/13

MEASURED BY	JR
DESIGNED BY	N.A.
DRAFTED BY	JR
CHECKED BY	P.M.
REVISED:	

SHEET #
03
OF 04

PROJECT:
2501
BUENA VISTA
DRIVE SE
THIRD FLOOR

DESCRIPTION:
AS-BUILT
DRAWING

CLIENT:
REIT
MANAGEMENT



YCD DESIGNS
505-899-1199