MAGNETIC

SSMH1
TOP=913.44
INV OUT=903.94

SSMH2
TOP=905.72
(A) INV IN=896.42
(B) INV IN=896.72
INV OUT=896.32

SSMH3
TOP=906.60

SSMH4
TOP=898.69

SSMH5
TOP=915.74
INV IN=908.54
INV OUT=908.44

SSMH6
TOP=918.34
(A) INV IN=909.54
(B) INV IN=909.54
INV OUT=909.44

SSMH7
TOP=916.13
INV IN=910.83
INV OUT=910.43

SSMH8
TOP=919.49
(A) INV IN=910.99
(B) INV IN=910.89
INV OUT=910.69

Course	Bearing	Distance
L1	N 89°44'17" W	37.92'
L2	S 00°20'45" W	58.54'
L3	N 89°44'17" W	26.33'

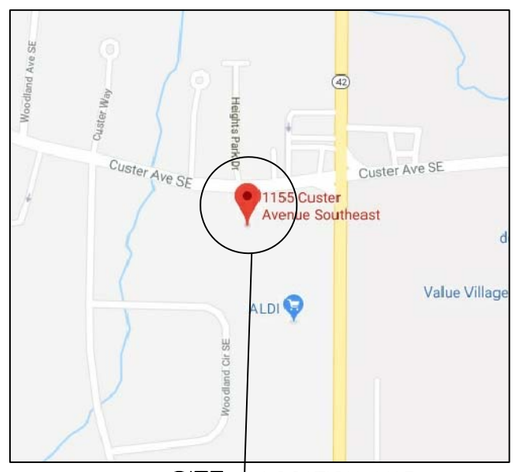

SITE LOCATION MAP
NOT SCALE

FLOOD NOTE:

I HAVE THIS DATE, EXAMINED THE "FIA FLOOD HAZARD MAP" AND FOUND IN MY OPINION REFERENCED PARCEL (●) (IS NOT) IN AN AREA HAVING SPECIAL FLOOD HAZARDS, WITHOUT AN ELEVATION CERTIFICATION SURVEYOR IS NOT RESPONSIBLE FOR ANY DAMAGE DUE ITS OPINION FOR SAID PARCEL
MAP ID 13121C0378F EFFECTIVE DATE: 09/18/2013
ZONE: X

THE FLOOD INFORMATION ON THIS PLAT HAS BEEN DETERMINED AFTER REVIEW OF MAPS WHICH ONLY APPROXIMATE THE LOCATION OF THE APPLICABLE FLOOD HAZARD AREA A SECOND OPINION OR COMPREHENSIVE FLOOD EVALUATION STUDY IS SUGGESTED FOR MORE ACCURATE INFORMATION. FOR FURTHER INFORMATION CONTACT THE LOCAL DRAINAGE DEPARTMENT, CORPS OF ENGINEERS AND INSURANCE COMPANY OR AN APPRAISER.

THIS PLAT WAS PREPARED TO SHOWN THE APPROXIMATE LOCATION OF THE IMPROVEMENTS AND IS NOT RECORDABLE. FENCES SHOULD NOT BE PLACED USING SIDE DIMENSIONS FROM HOUSE.
ALL MATTERS OF TITLE ARE EXCEPTED. THIS PLAT IS SUBJECT TO ALL LEGAL EASEMENTS AND RIGHT-OF-WAY PUBLIC OR PRIVATE.

ZONING NOTE:

BEFORE DEVELOPMENT OF THIS PROPERTY, DEVELOPER AND ARCHITECT TO CONFIRM ZONING DISTRICT, PER ZONING DEPARTMENT.

* SYMBOLS *

- ELECTRIC PANEL/METER
- WATER METER
- AIR CONDITIONER
- GAS METER
- JUNCTION BOX
- SANITARY SEWER MANHOLE
- STORM MANHOLE
- TRAFFIC/INFO SIGN
- GAS MARKER
- LAMP POST
- FIRE HYDRANT
- WATER VALVE
- HEADWALL
- STAIRS
- DRAINAGE INLET

* LINE INDICATORS *

- INDICATES SANITARY SEWER LINE
- INDICATES POWER LINE
- INDICATES WATER LINE
- INDICATES GAS LINE
- INDICATES DRAINAGE LINE
- INDICATES FENCE LINE

SURVEY NOTES:

1. STORM SEWER, SANITARY SEWER AND OTHER BURIED UTILITIES MAY HAVE BEEN PAVED OR COVERED OVER. THE LOCATION OF UNDERGROUND UTILITES AS SHOWN HEREON ARE BASED ON ABOVE GROUND STRUCTURES AND RECORD DRAWINGS PROVIDED TO THE SURVEYOR. LOCATION OF UNDERGROUND MAY VARY FROM LOCATIONS SHOWN HEREON. ADDITIONAL BURIED UTILITIES MAY BE ENCOUNTERED. NO EXCAVATIONS WERE MADE DURING THE PROCESS OF THIS SURVEY TO LOCATE BURIED UTILITIES. BEFORE EXCAVATIONS ARE BEGUN, TELEPHONE, ELECTRIC, WATER AND SEWER, GAS COMPANIES SHOULD BE CONTACTED FOR VERIFICATION OF UTILITY TYPE AND FOR FIELD LOCATIONS.
2. THIS PLAT WAS PREPARED TO SHOW THE APPROXIMATE LOCATION OF THE IMPROVEMENTS AND IS NOT RECORDABLE. FENCES SHOULD NOT BE LOCATED USING SIDE DIMENSIONS FROM THE HOUSE. ALL MATTERS OF THE TITLE ARE EXCEPTED. THIS PLAT IS SUBJECT TO ALL LEGAL EASEMENTS AND RIGHT OF WAY PUBLIC OR PRIVATE.
3. SURVEYOR HAS MADE NO INVESTIGATION OR INDEPENDENT SEARCH FOR EASEMENTS OF RECORD RECORDED AND NOT RECORDED, ENCUMBRANCES, RESTRICTIVE COVENANTS, OWNERSHIP TITLE EVIDENCE, OR ANY OTHER FACTS THAT AN ACCURATE AND CURRENT TITLE SEARCH MAY DISCLOSE.
4. THIS SURVEY WAS MADE WITHOUT THE BENEFIT OF CURRENT TITLE COMMITMENT, EASEMENTS AND ENCUMBRANCES MAY EXIST WHICH BENEFIT OR BURDEN THIS PROPERTY. MATTERS OF TITLE ARE EXCEPTED. PROPERTY OWNER OR PERSON ORDERING THE SURVEY IS RESPONSIBLE TO CONTACT CLOSING ATTORNEY OR TITLE COMPANY FOR A FULL TITLE SEARCH AND COMMITMENT INCLUDING ALL THE EXCEPTION.
5. SURVEY LAND EXPRESS, INC IS NOT RESPONSIBLE FOR AND DOES NOT WARRANT THE ZONING INFORMATION AND INTERPRETATION AS PROVIDED HEREIN. THIS INFORMATION IS OBTAINED USING ON-LINE SOURCES, TELEPHONE CONVERSATION WITH ZONING OFFICE AT THE COUNTY OR CITY, ETC. AND CANNOT GUARANTEE ITS ACCURACY. IT IS RECOMMENDED THAT THE CLIENT OR USER OF THIS DATA VERIFY THIS INFORMATION WITH THE ISSUING AUTHORITY.
6. THIS PLAT WAS PREPARED FOR THE EXCLUSIVE USE OF THE PERSON, PERSONS OR ENTITY NAMED HEREON. THIS PLAT DOES NOT EXTEND TO ANY UNNAMED PERSON, PERSONS, OR ENTITY WITHOUT THE EXPRESS RECERTIFICATION OF THE SURVEYOR NAMING SUCH PERSON, PERSONS, ENTITY.

* L E G E N D *

APD	AS PER DEED	IR	IRON ROD FOUND
AE	ACCESS EASEMENT	IV	IRRIGATION VALVE
APF	AS PER FIELD	JB	JUNCTION BOX
AI	ANGLE IRON FOUND	LLL	LAND LOT LINE
APP	AS PER PLAT	MAG	MAGNETIC READING IP
APR	AS PER RECORD	MGN	MAGNOLIA TREE
BC	BACK OF CURB	MH	MAN HOLE
BLK	BLOCK	MTF	METAL FENCE
BLS	BUILDING LINE SETBACK	N	N'BORS.
BRK	BRICK	OH	OVERHANG
BSMT	BASEMENT	OTP	OPEN TOP PIPE FOUND
CBX	CABLE BOX	OU	OWNERSHIP UNCLEAR
C.	CONCRETE	P	PORCH
CB	CATCH BASIN	PC	PROPERTY CORNER
CL	CENTER LINE	PL	PROPERTY LINE
CLF	CHAIN LINK FENCE	PN	PINE TREE
CMP	CORRUGATED METAL PIPE	POB	POINT OF BEGINNING
C.O.A.	CITY OF ATLANTA	PP	POWER POLE
CO	SAN SEWER CLEANOUT	PW	POWER LINE
CRWL	CRAWL SPACE	P.	PORCH
CP	CALCULATED POINT	(P)	PLAT
CPT	CARPORT	R	RECORD
CTP	CRIMP TOP PIPE FOUND	RBF	REINFORCING BAR FOUND
D	DEED	RBS	REINFORCING BAR SET
DE	DRAINAGE EASEMENT	RCP	REINFORCED CONC. PIPE
DI	DRAINAGE INLET	R/W	RIGHT-OF-WAY
EB	ELECTRIC POWER BOX	SN	SIGN
EM	ELECTRIC METER	SSL	SANITARY SEWER LINE
EP	EDGE OF PAVEMENT	SSE	SANITARY SEWER EASEMENT
F	FIELD	SP	SCREENED PORCH
FP	FENCE POST	SW	SIDEWALK
FC	FENCE CORNER	TB	TOP OF BANK
FH	FIRE HYDRANT	UE	UTILITY EASEMENT
FR	FRAME	WD	WOOD
GL	GAS LINE	WDF	WOOD FENCE
GM	GAS METER	WDK	WOOD DECK
GV	GAS VALVE	WL	WATER LINE
GW	GUY WIRE	WM	WATER METER
HDW	HEAD WALL	WRF	WIRE FENCE
HW	HARDWOOD TREE	WV	WATER VALVE
IPF	IRON PIN FOUND	WW	WET WEATHER
IPS	IRON PIN SET	W/	WITH/
		YI	YARD INLET

PROPERTY IS ZONED C-1-C
(COMMUNITY BUSINESS DISTRICT REGULATIONS)
CITY OF ATLANTA
BUILDING SETBACK:
FRONT: 10.0'
SIDE: 5.0'/20.0'
REAR: 20.0'
MAX BUILDING HEIGHT 35'

TOTAL LAND AREA
58025.13 SF / 1.332 AC

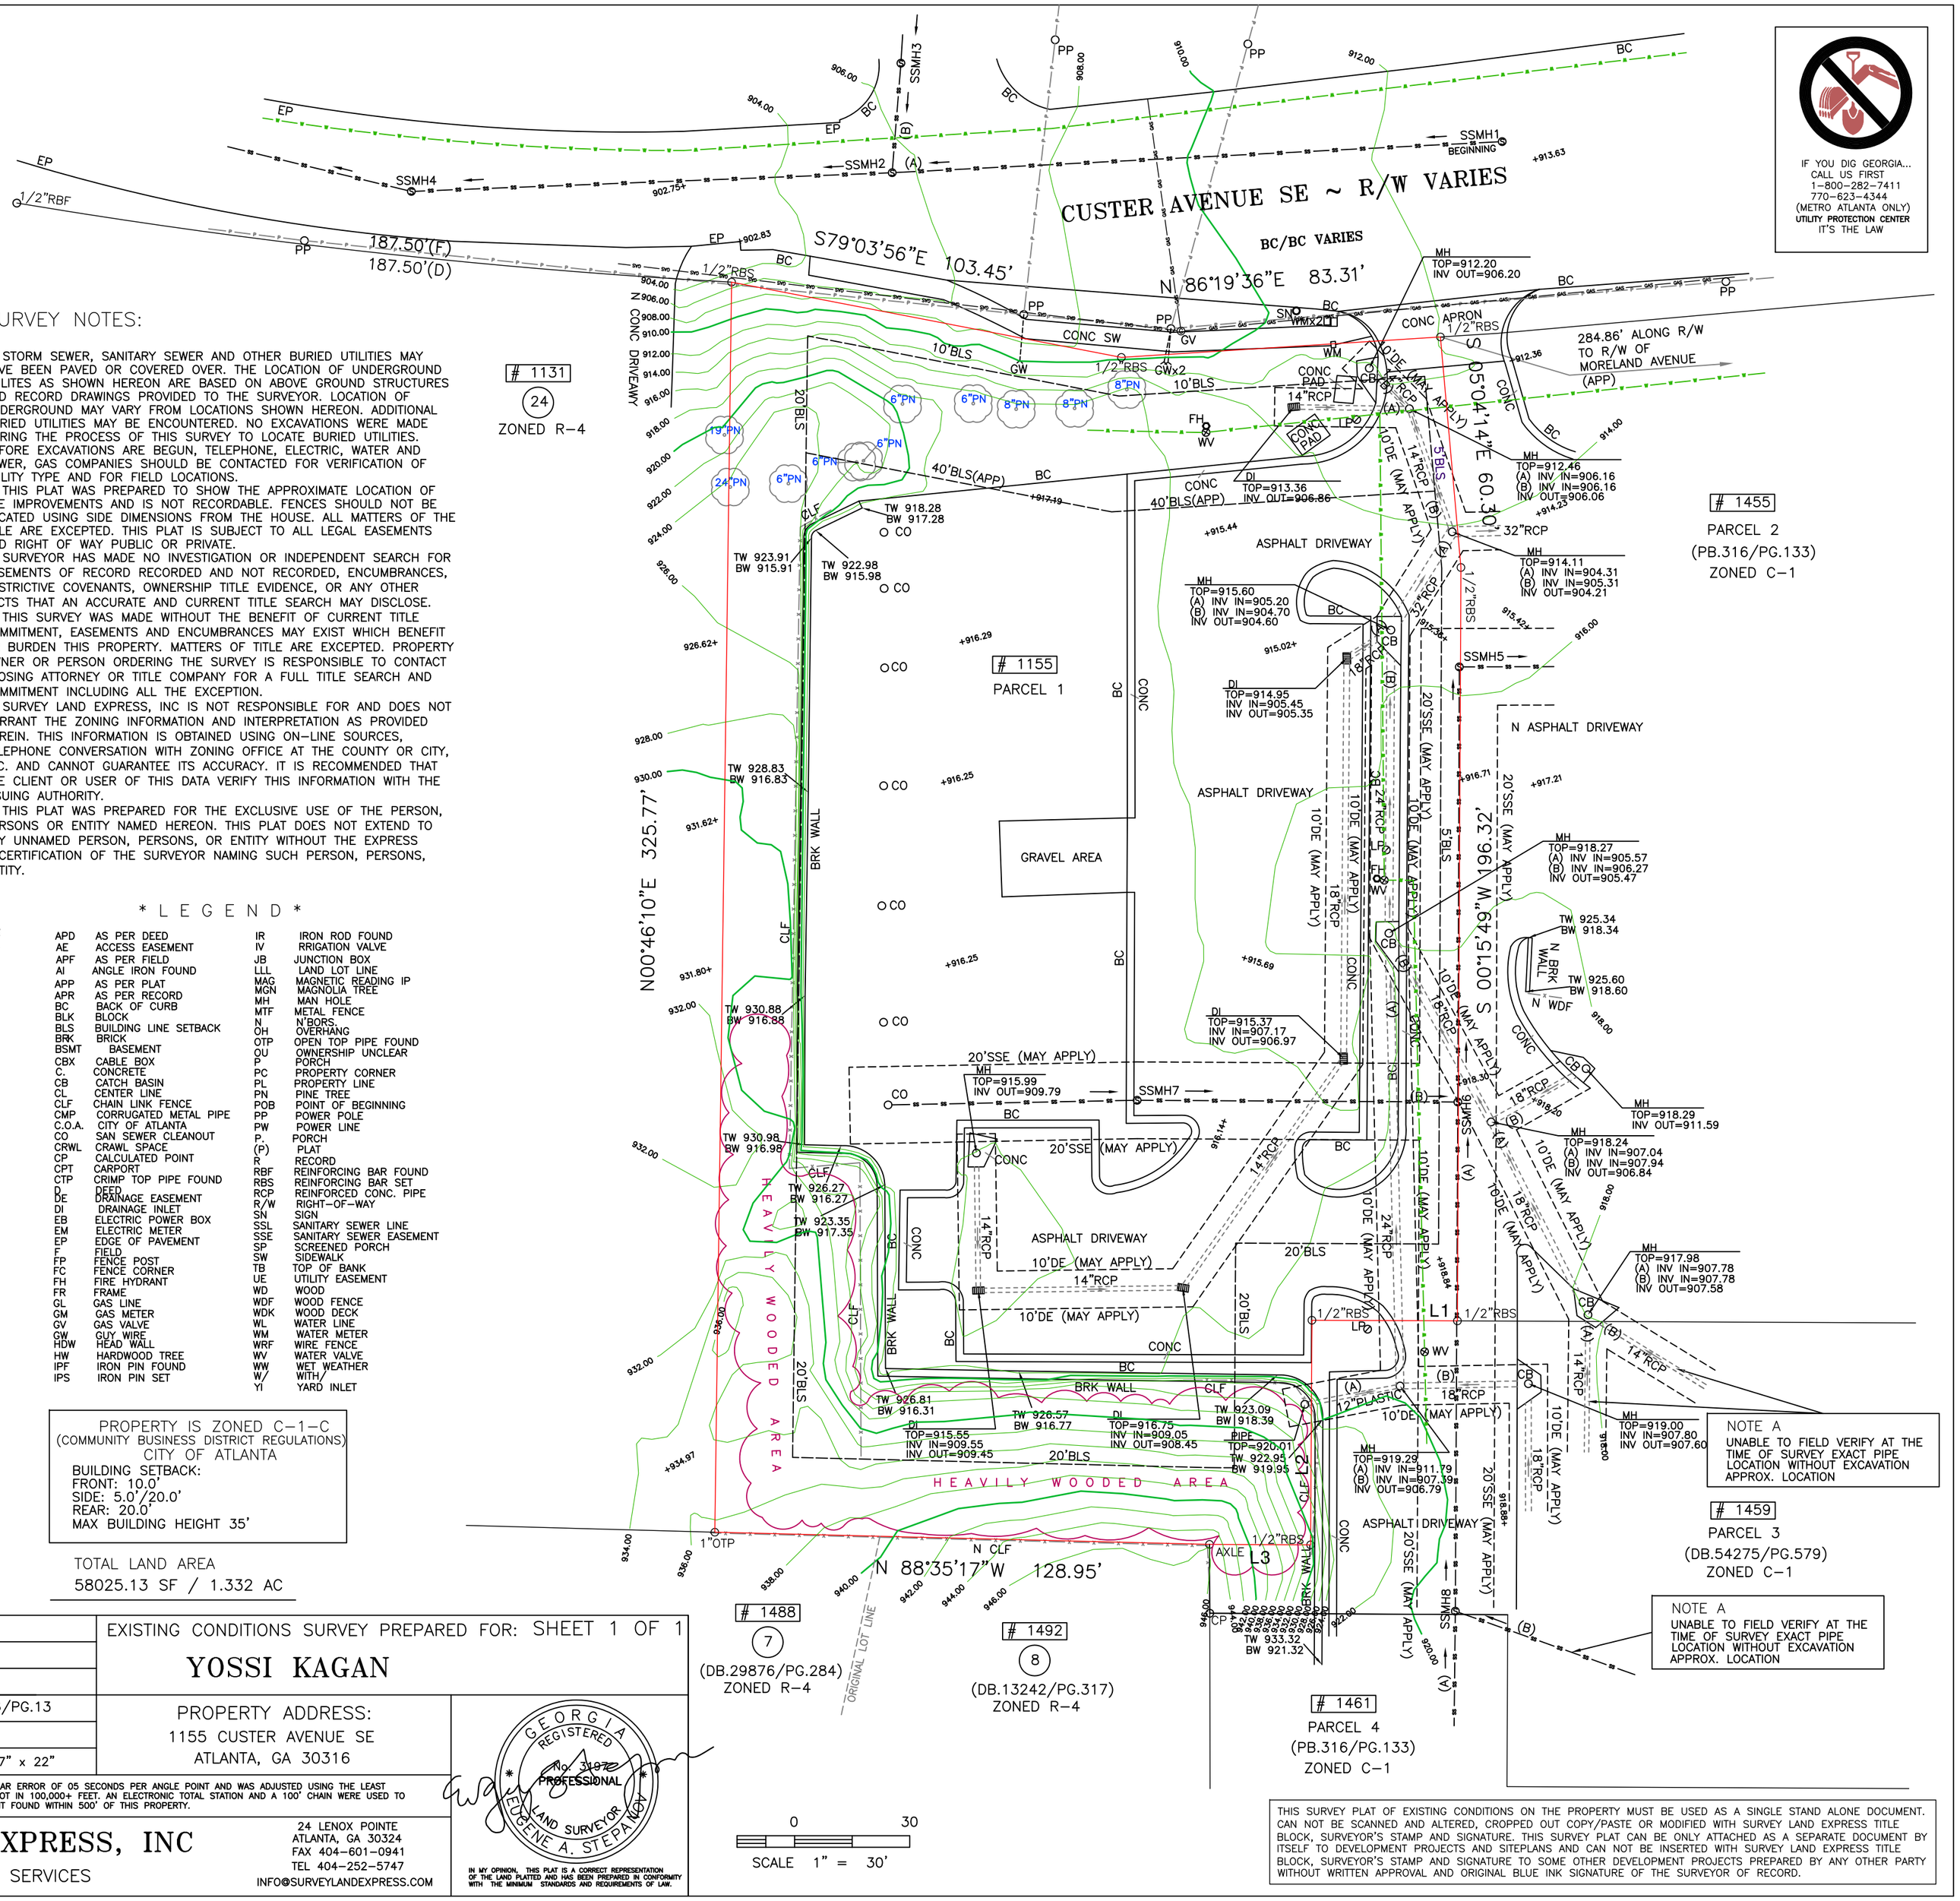

0 30
SCALE 1" = 30'

IF YOU DIG GEORGIA...
CALL US FIRST
1-800-282-7411
770-623-4344
(METRO ATLANTA ONLY)
UTILITY PROTECTION CENTER
IT'S THE LAW

PARCEL 1	BLOCK	
SUBDIVISION	UNIT	
LAND LOT 9	14TH DISTRICT	SECTION
FULTON COUNTY, GEORGIA	DB.45174/ PG.689	PB.316/PG.13
FIELD WORK DATE JUN 20, 2018	PRINTED/SIGNED JUN 27, 2018	
ALL MATTERS PERTAINING TO TITLE ARE EXCEPTED	PAPER SIZE: 17" x 22"	

EXISTING CONDITIONS SURVEY PREPARED FOR: SHEET 1 OF 1

YOSSI KAGAN

PROPERTY ADDRESS:
1155 CUSTER AVENUE SE
ATLANTA, GA 30316

THE FIELD DATA UPON WHICH THIS PLAT IS BASED HAS A CLOSURE OF 1 FOOT IN 30,000+ FEET, AN ANGULAR ERROR OF 05 SECONDS PER ANGLE POINT AND WAS ADJUSTED USING THE LEAST SQUARES METHOD. THIS PLAT HAS BEEN CALCULATED FOR CLOSURE AND FOUND TO BE ACCURATE TO 1 FOOT IN 100,000+ FEET. AN ELECTRONIC TOTAL STATION AND A 100' CHAIN WERE USED TO GATHER THE INFORMATION USED IN THE PREPARATION OF THIS PLAT. NO STATE PLANE COORDINATE MONUMENT FOUND WITHIN 500' OF THIS PROPERTY.

GEORGIA REGISTERED No. 3197 PROFESSIONAL LAND SURVEYOR EUGENE A. STEPANOV

IN MY OPINION, THIS PLAT IS A CORRECT REPRESENTATION OF THE LAND PLATTED AND HAS BEEN PREPARED IN CONFORMITY WITH THE MINIMUM STANDARDS AND REQUIREMENTS OF LAW.

LK
COORD #20181356
DWG #20181356

SURVEY LAND EXPRESS, INC
LAND SURVEYING SERVICES
24 LENOX POINTE
ATLANTA, GA 30324
FAX 404-601-0941
TEL 404-252-5747
INFO@SURVEYLANDEXPRESS.COM

THIS SURVEY PLAT OF EXISTING CONDITIONS ON THE PROPERTY MUST BE USED AS A SINGLE STAND ALONE DOCUMENT. CAN NOT BE SCANNED AND ALTERED, CROPPED OUT COPY/PASTE OR MODIFIED WITH SURVEY LAND EXPRESS TITLE BLOCK, SURVEYOR'S STAMP AND SIGNATURE. THIS SURVEY PLAT CAN BE ONLY ATTACHED AS A SEPARATE DOCUMENT BY ITSELF TO DEVELOPMENT PROJECTS AND SITEPLANS AND CAN NOT BE INSERTED WITH SURVEY LAND EXPRESS TITLE BLOCK, SURVEYOR'S STAMP AND SIGNATURE TO SOME OTHER DEVELOPMENT PROJECTS PREPARED BY ANY OTHER PARTY WITHOUT WRITTEN APPROVAL AND ORIGINAL BLUE INK SIGNATURE OF THE SURVEYOR OF RECORD.